



US Army Corps
of Engineers
Alaska District




ALASKA COASTAL EROSION

SHISHMAREF, ALASKA

INDEX TO DRAWINGS

- G-1 COVER SHEET
- W-1 LOCATION AND VICINITY MAP
- W-2 GENERAL PLAN AND SURVEY CONTROL
- W-3 SITE PLAN (BASE ITEM)
- W-4 SITE PLAN (OPTION ITEMS)
- W-5 REVETMENT TYPICAL SECTIONS I
- W-6 REVETMENT TYPICAL SECTIONS II
- W-7 UNALAKLEET STOCKPILE SITE
- W-8 EXHIBIT I
- W-9 EXHIBIT II
- W-10 EXHIBIT III

CONTRACT NO. W911KB-07-C-0022

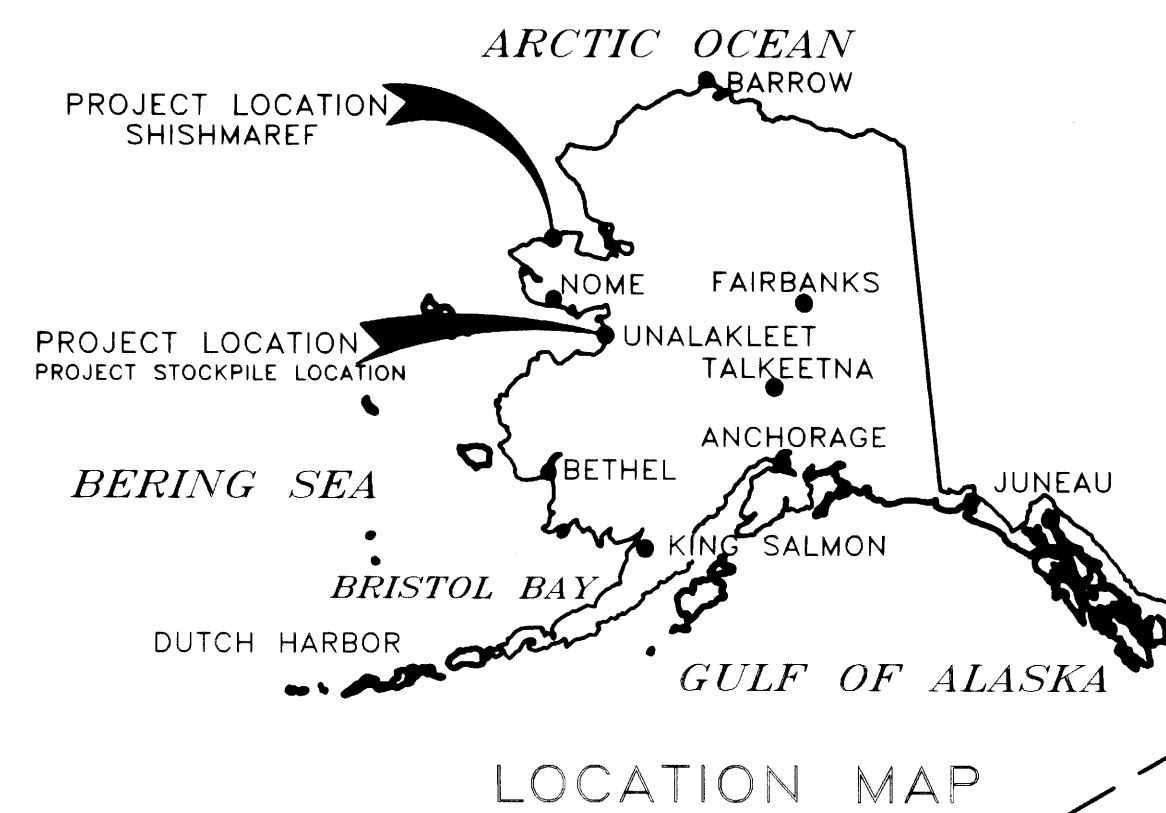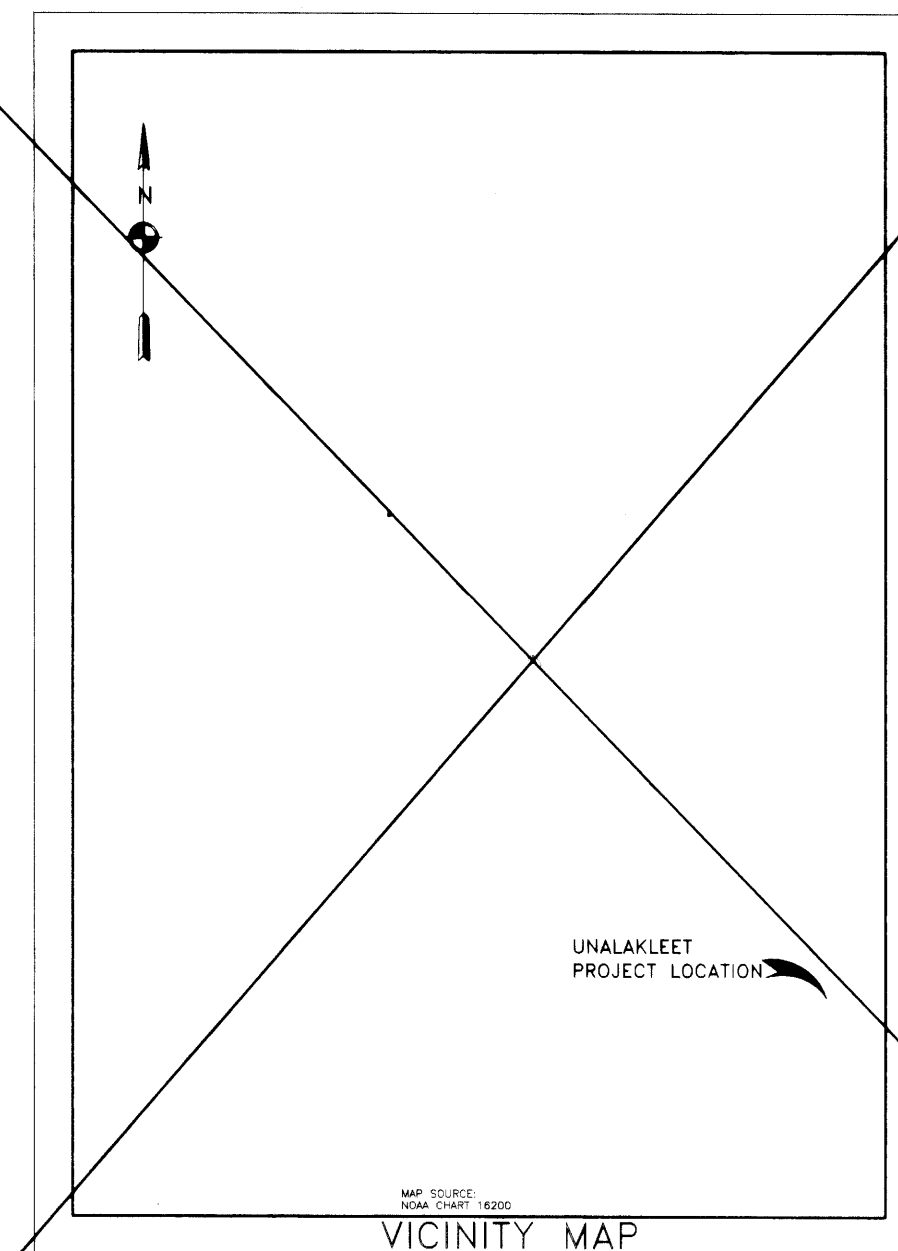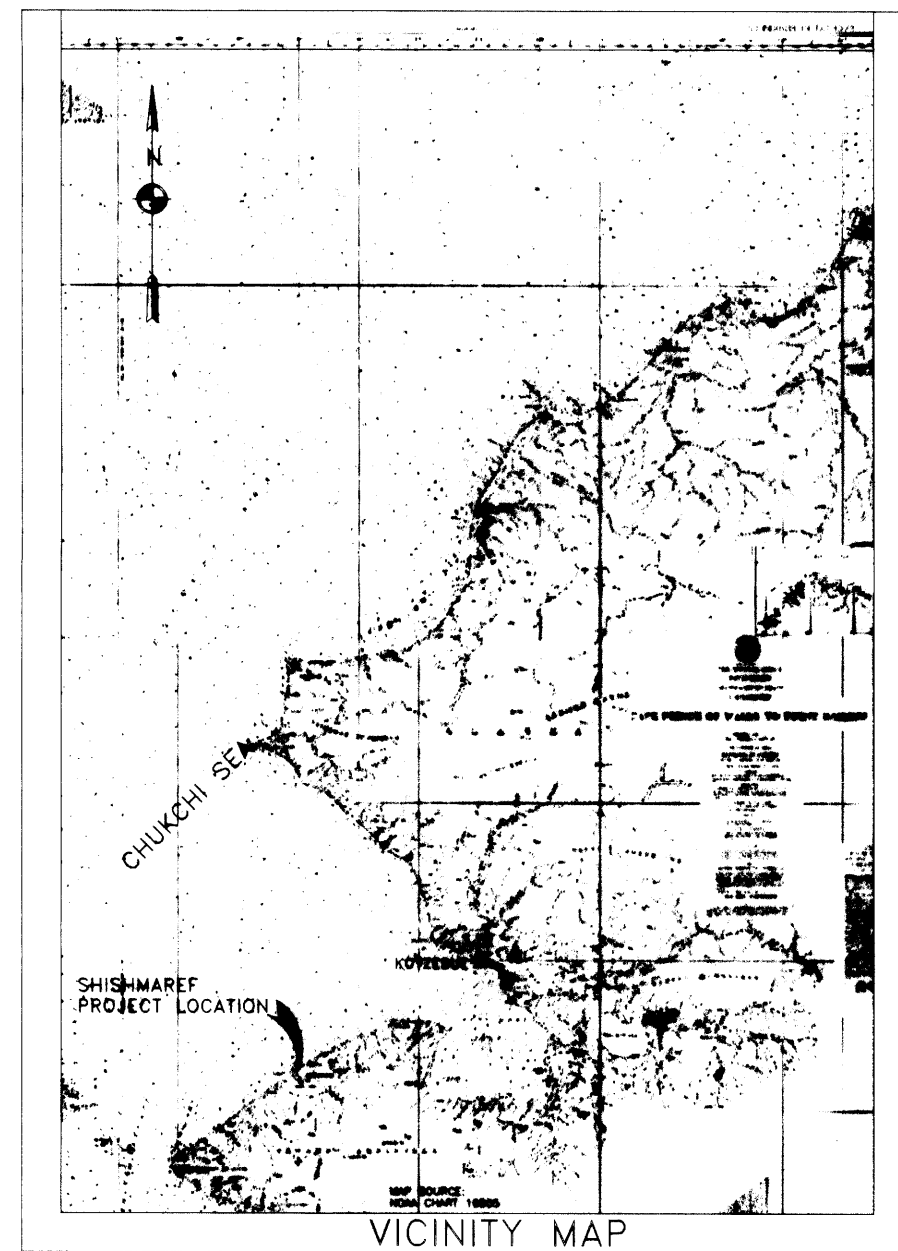



- NOTES:
1. THERE IS NO CONTRACTOR STAGING AREA OR STOCKPILING AREA PROVIDED FOR THIS CONTRACT.
 2. SHORELINE AND BOTTOM CONTOURS SHOWN REFLECT CONDITIONS AT THE TIME OF THE PHOTOGRAPH. BOTTOM AND SHORELINE CONTOURS ARE SUBJECT TO CHANGE DUE TO EROSION.
 3. THIS PROJECT IS IN ENGLISH UNITS. ALL DISTANCES, STATIONING, DEPTHS ARE FEET.
 4. DURING STORM SURGE CONDITIONS WATER LEVELS CAN RISE TO +13 FEET MLLW.
 5. FREEZE UP IN THE AREA CAN OCCUR IN LATE OCTOBER AND BREAKUP CAN OCCUR IN MID MAY. WAVES AND CURRENTS CAN BE SEVERE
 6. THE CONTRACTOR SHALL REMOVE ALL VEGETATION, DRIFTWOOD LOGS, AND MISCELLANEOUS DEBRIS PRIOR TO PLACEMENT OF ROCK. MATERIALS REMOVED SHALL BE DISPOSED OF IN A APPROVED DISPOSAL AREA IN COORDINATION WITH THE CITY OF SHISHMAREF. COORDINATION FOR THE CITY OF SHISHMAREF. CAN BE MADE THROUGH THE CITY CLERK, MELANIE WEYOUANNA (907) 649-3781. OR BY FAX (907) 649-2131, OR EMAIL SSHCITYCLERK@YAHOO.COM.
 7. STORE AND BUILDINGS IN CONSTRUCTION AREA ARE CURRENTLY IN USE AND OCCUPIED. WORK AROUND OCCUPANTS.
 8. THE CONTRACTOR SHALL LOCATE EXISTING UTILITIES IN THE FIELD PRIOR TO THE COMMENCEMENT OF WORK.
 9. THE CONTRACTOR SHALL REMOVE THE TOP TIER OF CONCERTAINERS FROM THE SEA WALL PRIOR TO CONSTRUCTING THIS REVETMENT. SEE SHEET W-10.
 10. TIDAL DATA SHOWN ON THIS SHEET FOR SHISHMAREF IS NOT REFERENCED TO THE SURVEY DATA ON SHEET W-2.

TIDAL DATA, SHISHMAREF INLET, ALASKA			DATUM MLLW
MEAN HIGHER HIGH WATER (MHHW)	1.0 FEET		
MEAN HIGH WATER (MHW)	.87 FEET		
MEAN SEA LEVEL (MSL)	.50 FEET		
MEAN LOW WATER (MLW)	.11 FEET		
MEAN LOWER LOW WATER (MLLW)	0.0 FEET		

SOURCE: NOAA NATIONAL OCEAN SERVICE

TIDAL DATA UNALAKLEET, ALASKA			DATUM MLLW
MEAN HIGHER HIGH WATER (MHHW)	3.8 FEET		
MEAN HIGH WATER (MHW)	3.3 FEET		
MEAN SEA LEVEL (MSL)	1.8 FEET		
MEAN LOWER LOW WATER (MLLW)	0.0 FEET		

SOURCE: NOAA NATIONAL OCEAN SERVICE

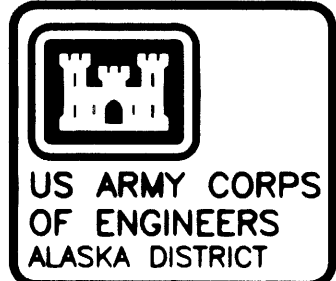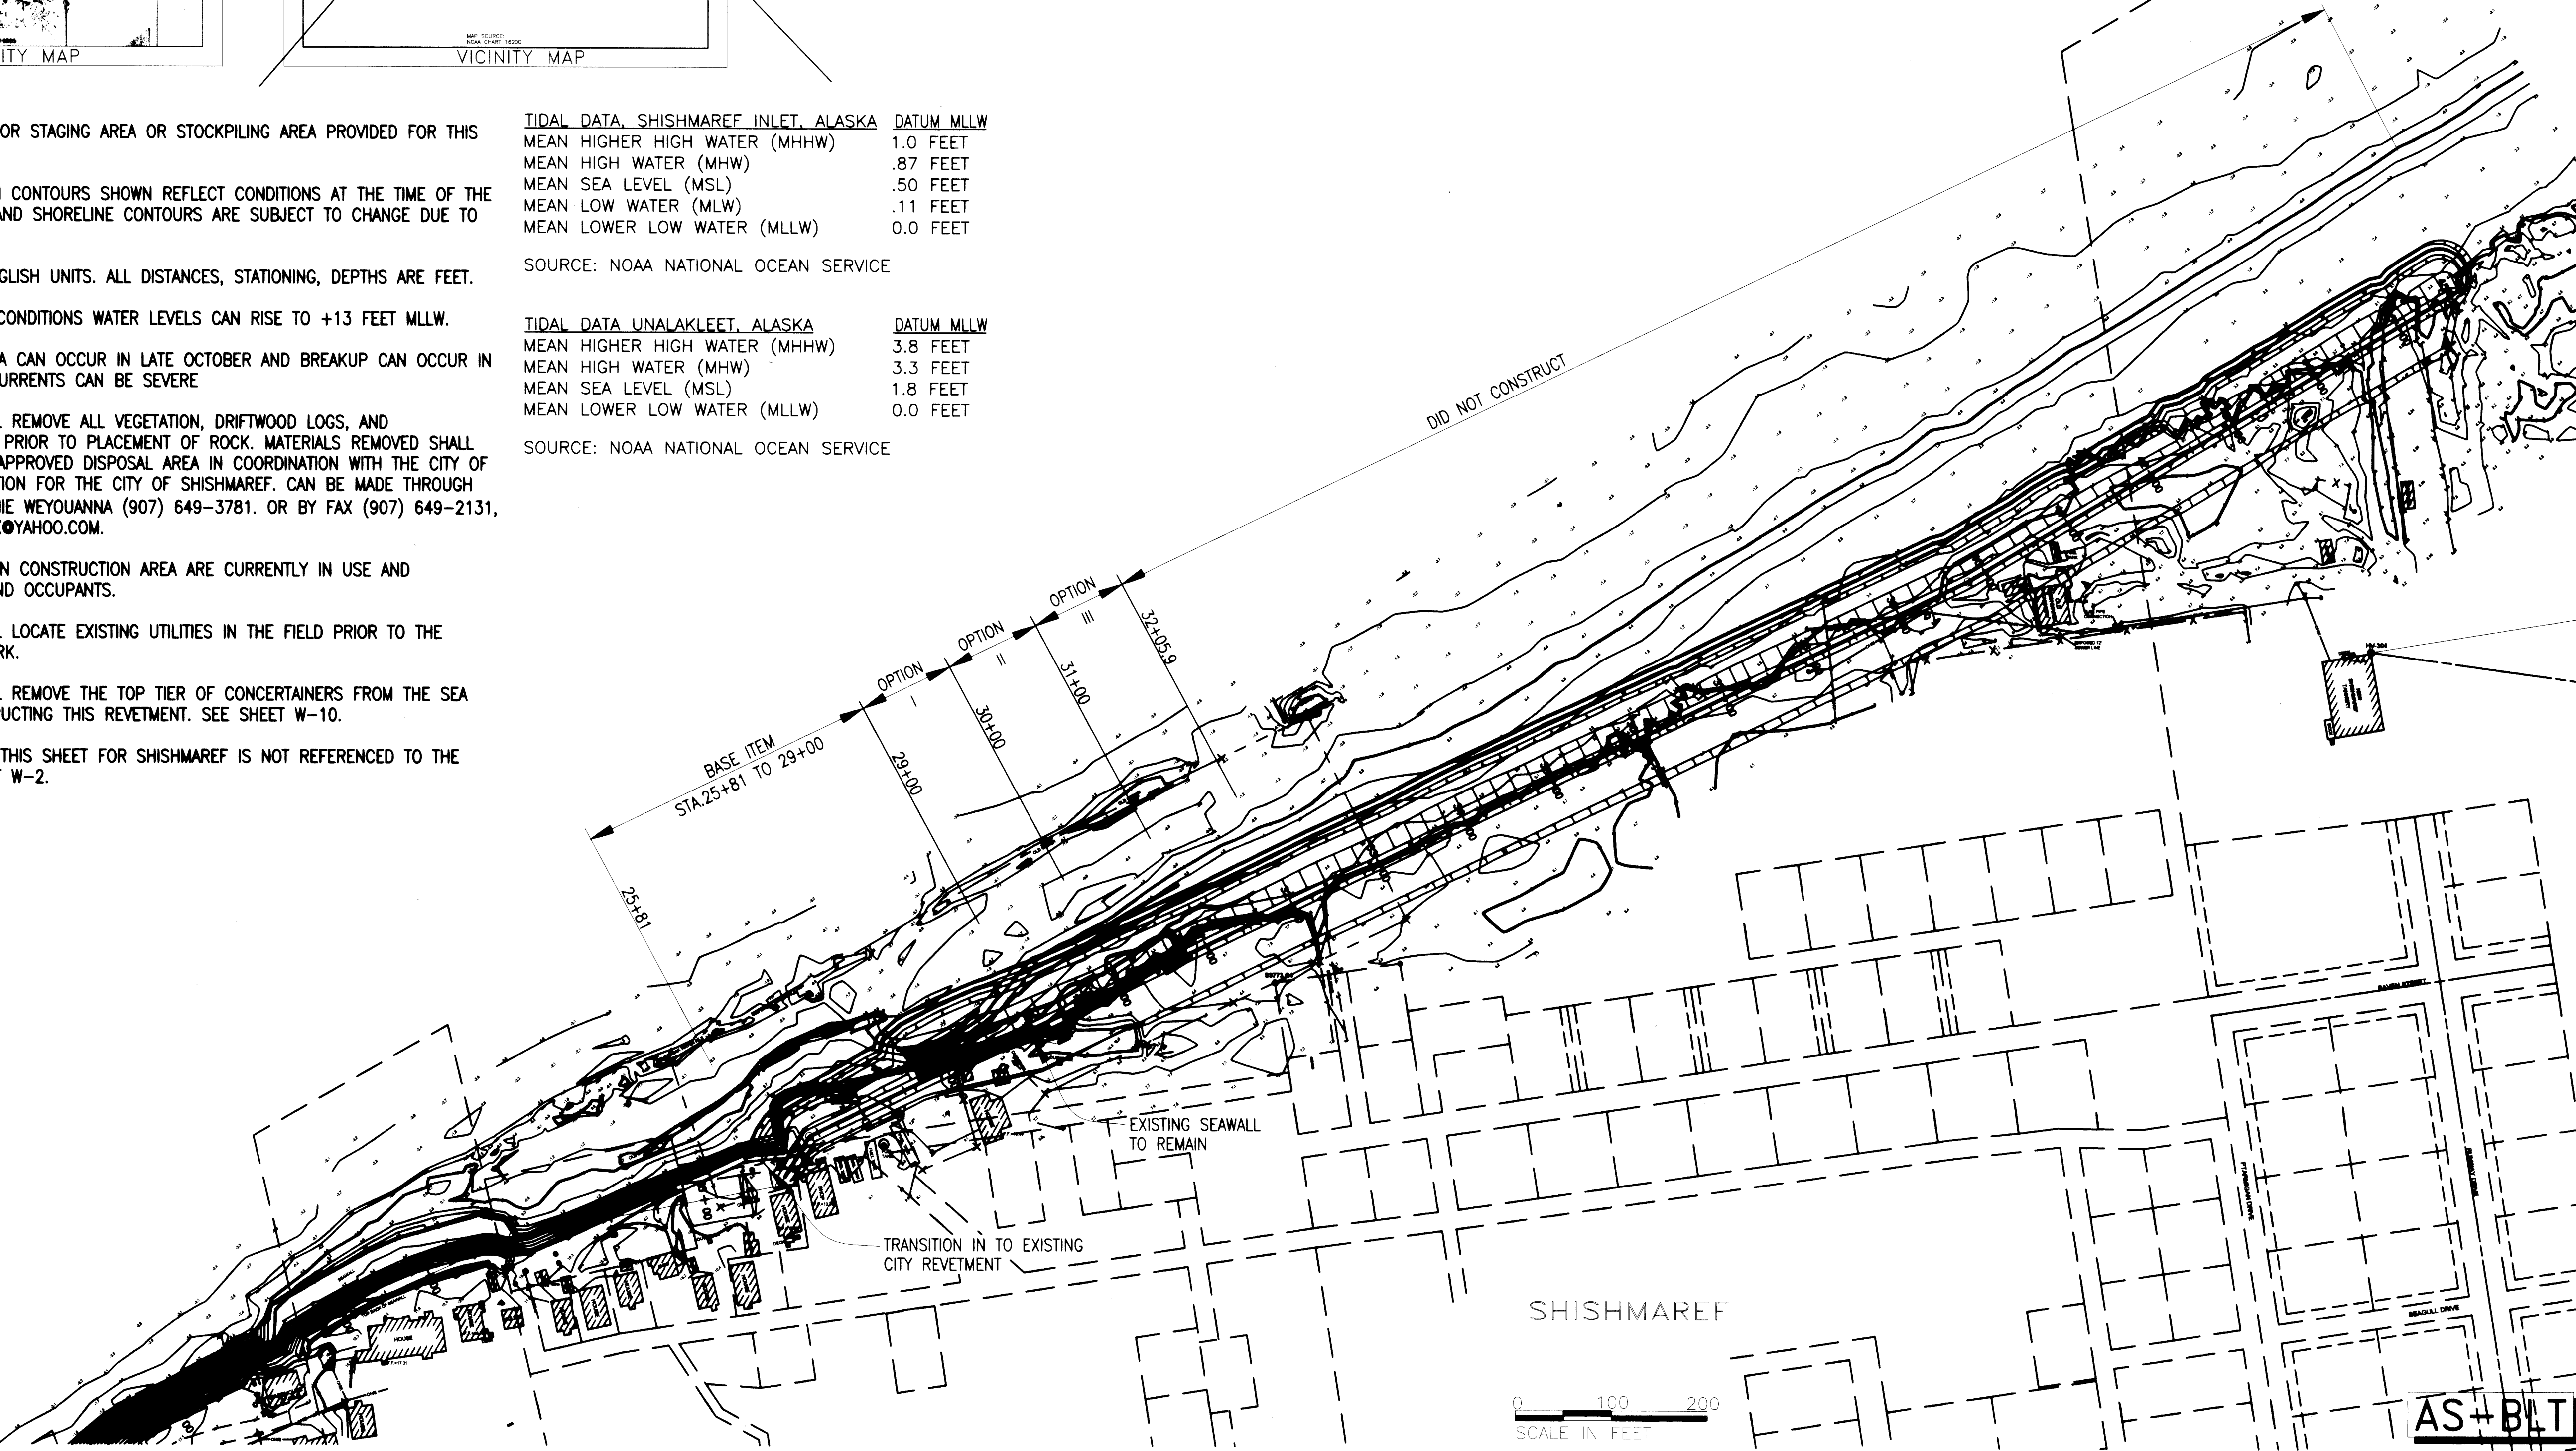

CONTRACT NO. W911KB-07-R-0011
CONTRACTOR: [Signature]
CITY: ANCHORAGE
STATE: AK
DATE: 2/22/07
APPROVED: [Signature]

DATE: APR 24, 2007
NOTED: [Signature]
DATE: 4/24/07
NOTED: [Signature]

U.S. ARMY ENGINEER DISTRICT
CORPS OF ENGINEERS
ANCHORAGE, ALASKA
D.W.M. J.E.F.
K. Eises
D. Hardy
INV. NO. W911KB-07-R-0011
SH081818

SHISHMAREF & UNALAKLEET, ALASKA
ALASKA COASTAL EROSION
HYDRAULICS & HYDROLOGY
CIVIL WORKS
LOCATION AND VICINITY MAP

Reference number:
W-1
Sheet 2 of 11

AS-BLT

HORIZONTAL CONTROL

Coordinates are ASPC Zone 8, NAD 83(1986) in U.S. Feet. The Basis of Coordinates is Corner 2, US SURVEY NO. 3773, ALASKA, EMBRACING LOTS 1, 2, and 3 (C2, USS3773), said corner being a Bureau of Land Management Brass Cap having a value of N4,479,301.98 and E1,631,612.52. The NAD 83(1986) position for this monument was established by Global Positioning Services, Inc. (GPS, Inc.) from GPS observations taken in September, 2004 referenced to USC&GS Station "WALES" located at the Village of Wales approximately 68 miles southwest of Shishmaref. NAD 83(1986) values for "WALES 1944" held by GPS, Inc. are N65°37'20.13825" and W168°05'38.34415".

Positions for other control points shown hereon were derived from static differential GPS observations and conventional traverse methods performed by DOWL Engineers in August, 2006.

PROJECT SCALE FACTOR

The Project Combined Scale Factor is 0.99989880. To convert ground distances to ASP grid distances, multiply by a combined scale factor of 0.99989880. To convert ASP grid distances to ground distances, multiply by a combined scale factor of 100000000/99989880.

VERTICAL CONTROL

The true relationship of control points shown hereon to any tidal datum is unknown.

Elevations are based on photo control point HV-305, a P.K. nail in a large "X" painted yellow near the south end of the old asphalt runway, said nail having a value of 5.23 feet related to this project. The elevation for HV-305 was established by Global Positioning Services, Inc. (GPS, Inc.) from GPS observations taken in September, 2004 referenced to the NGVD 29 elevation for USC&GS Station "WALES" located at the Village of Wales approximately 68 miles southwest of Shishmaref. The NGVD 29 value for "WALES" held by GPS, Inc. is 16.0 feet.

Elevations for other control points shown hereon were derived by differential leveling performed by DOWL Engineers in August, 2006.

PROPERTY NOTE

Property information shown hereon has been generated from readily available sources with limited ties to property corners and limited accuracy checks. Property information research includes an on-line search of the State Recorder's Office records posted on the internet only. Unrecorded subdivisions, land transactions, or other information not posted on the State Recorder's Office website may exist. A thorough title search is recommended if new construction is anticipated to encroach onto private properties. Generally, the information shown hereon is current as of August, 2006.

SURVEY CONTROL POINTS

POINT	NORTHING	EASTING	ELEVATION	DESCRIPTION
HV-305	4,478,683.66	1,632,016.38	5.23	Magnail
S3773 C2	4,479,301.98	1,631,612.52	7.47	Brass Cap
S3773 C3	4,479,156.84	1,630,667.32	4.47	Brass Cap
S3773 C4	4,479,900.44	1,630,553.85	7.02	Brass Cap
SACE-1	4,478,212.13	1,628,872.58	7.62	Alum Mon
SACE-2	4,478,772.58	1,631,955.99	4.80	Alum Mon

LEGEND

- SURVEY MONUMENT
- PROPERTY MONUMENT
- POWER POLE
- POWER POLE W/ GUY ANCHOR
- LIGHT FIXTURE
- △ TRANSFORMER
- VALVE
- SIGN
- GUARD POST/BOLLARD
- FINISH FLOOR
- SPOT ELEVATION
- FENCE LINE
- OVERHEAD ELECTRIC
- EDGE OF PAVEMENT
- EDGE OF GRAVEL / DIRT
- BUILDING
- MINOR CONTOUR
- MAJOR CONTOUR

CENTERLINE ALIGNMENT TABLE

1.	10+00	N 4,478,932.49	E 1,628,669.13	
2.	20+41.93	N 4,479,524.19	E 1,629,524.03	LPT-1
3.	22+86	N 4,479,632.37	E 1,629,756.69	LPT-2
4.	25+80.94	N 4,479,711.10	E 1,630,030.26	LPT-3
5.	26+50.40	N 4,479,761.78	E 1,630,077.75	LPT-4
6.	39+80	N 4,480,320.39	E 1,631,272.50	LPT-5
7.	45+64	N 4,480,620.29	E 1,631,773.61	EOP

REVTMENT SCHEDULE TABLE


1.	BASE ITEM STA 25+75 TO 29+00 PLUS END SECTION
2.	OPTION I STA 29+00 TO 30+00
3.	OPTION II STA 30+00 TO 31+00
4.	OPTION III STA 31+00 TO 32+00

DID NOT CONSTRUCT

CONSTRUCTION BOUNDARY

SHISHMAREF

BASIS OF BEARING - S81° 59' 58" E - 6
(SEE INSET ABOVE)

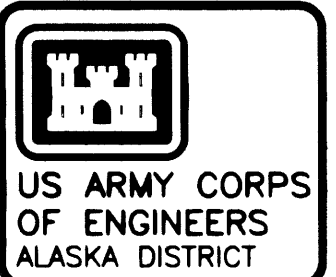


CONTRACT NO. W-2-07-0002
CONTRACTOR: ARCADIS
CITY: ANCHORAGE
STATE: AK
APPROVED: [Signature]
DATE: 8/2/06

APR 24 2007
NOTED
K. G. GARDY
SHISHMAREF-03-W-2
SH081818-07-R-0011
INV. NO. W911KB-07-R-0011
SH081818

U.S. ARMY ENGINEER DISTRICT
CORPS OF ENGINEERS
ANCHORAGE, ALASKA
SHISHMAREF & UNALAKLET, ALASKA
ALASKA COASTAL EROSION
HYDRAULICS & HYDROLOGY
CIVIL WORKS
GENERAL PLAN AND SURVEY CONTROL

Reference number:
W-2
Sheet 3 of 11

AS-BLT

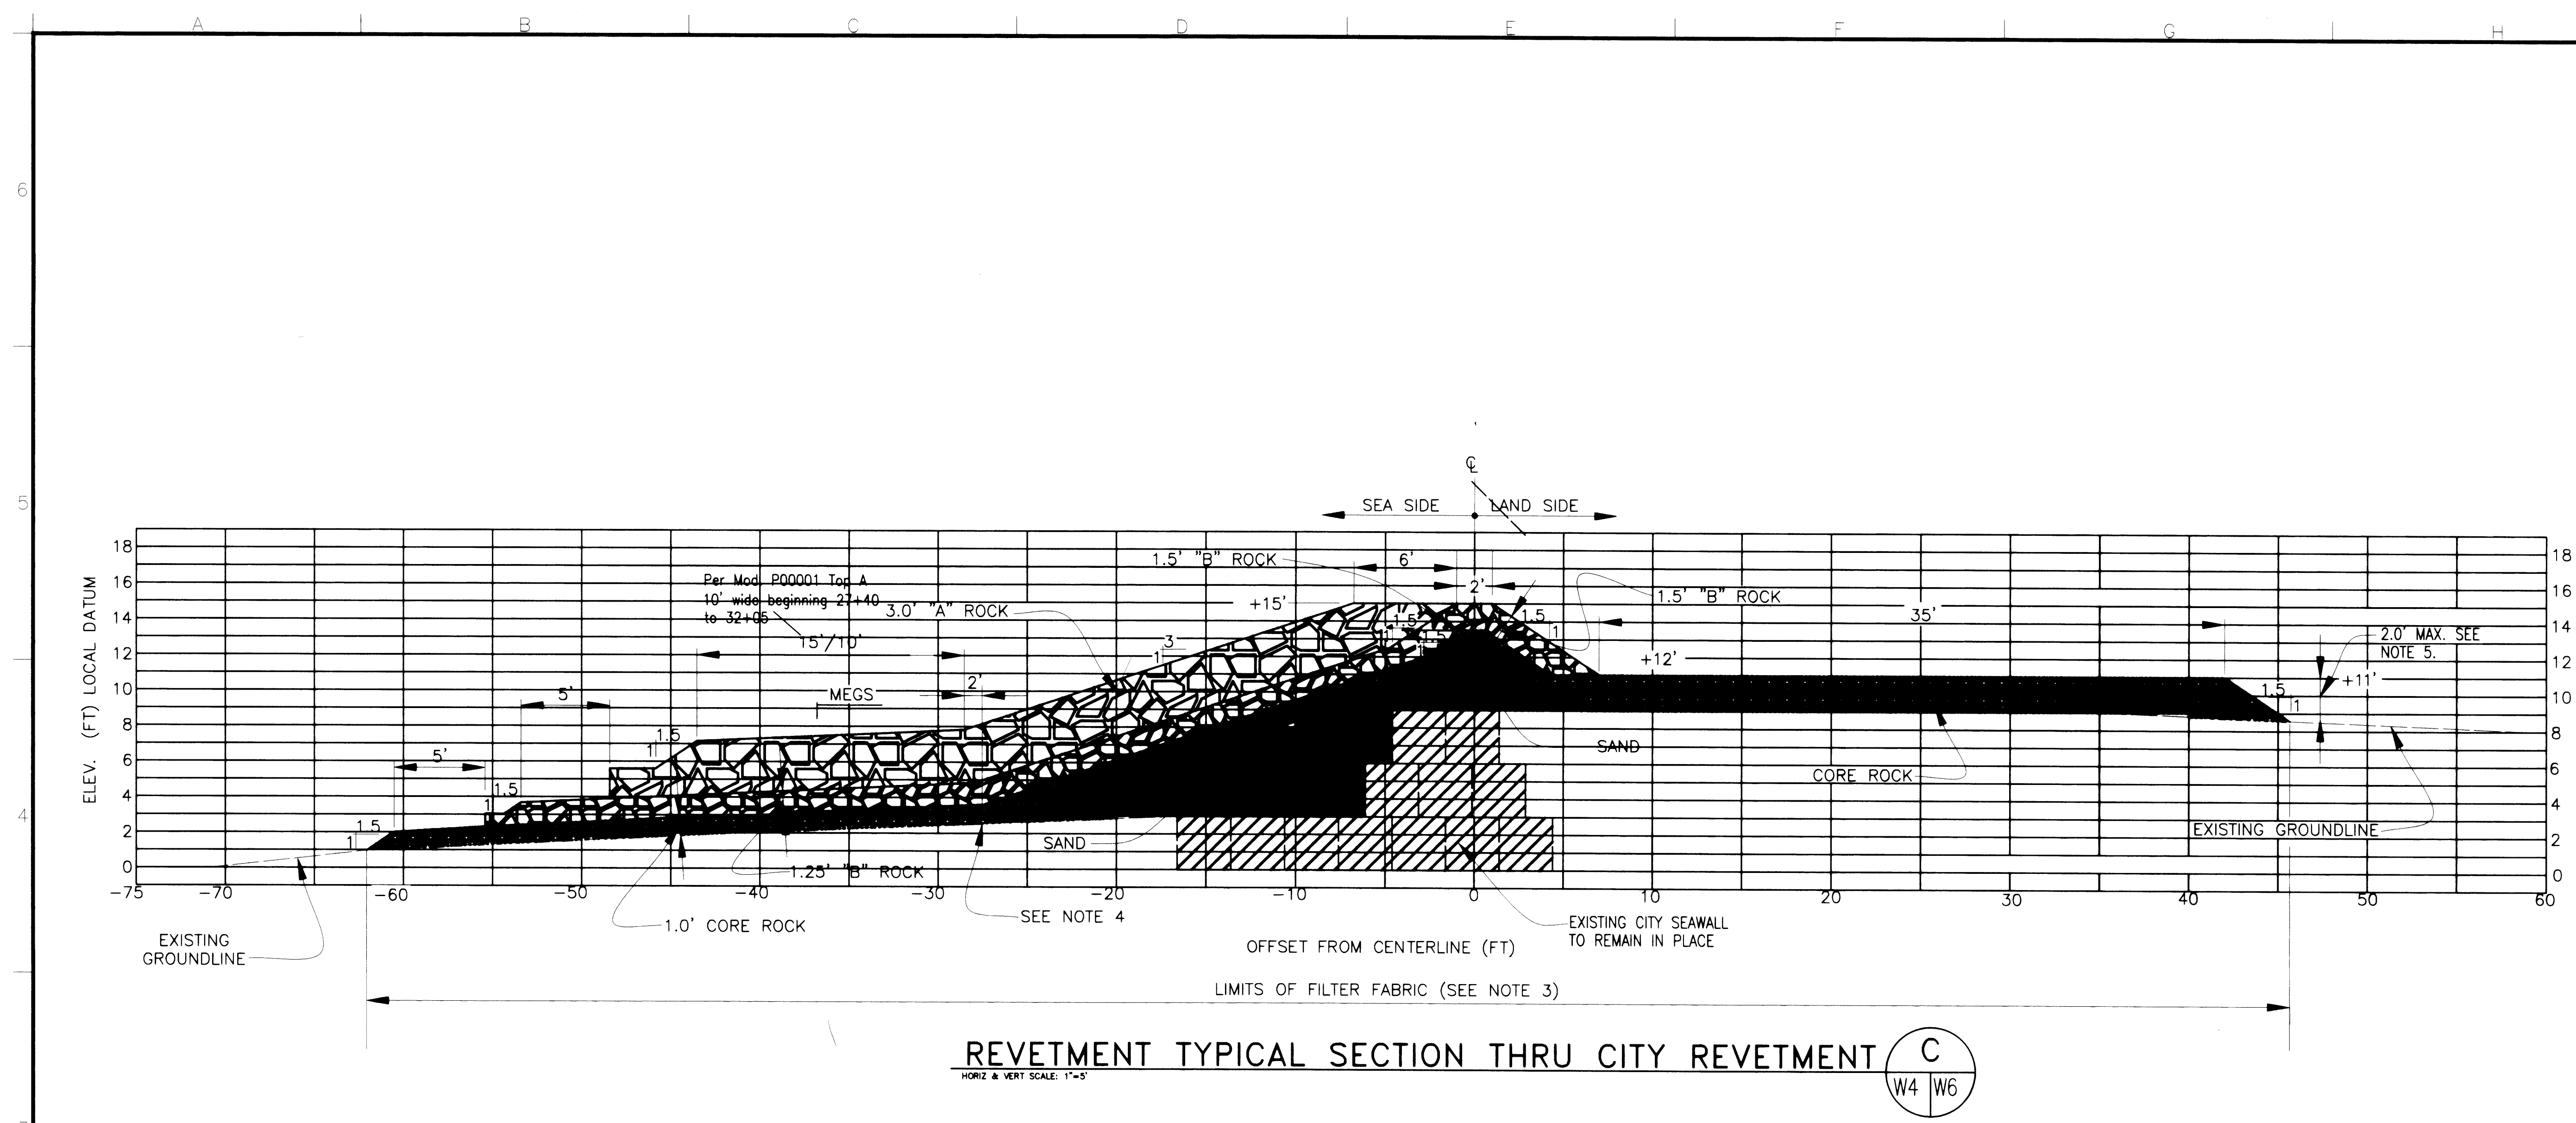

- NOTES:
1. POSITIVE OFFSETS ARE MEASURED TO THE RIGHT OF THE PROJECT BASELINE. NEGATIVE OFFSETS ARE MEASURED TO THE LEFT OF THE PROJECT BASELINE. ELEVATIONS ARE REFERENCED TO LOCAL DATUM IN FEET.
 2. THE CONTRACTOR SHALL REMOVE ALL SECTIONS OF OVERHANG BANK PRIOR TO ANY ROCK PLACEMENT. THE SLOPE SHALL BE PREPARED TO PREVENT VOIDS WITHIN THE REVETMENT CROSS-SECTION AND IN THE FILL MATERIAL. BEFORE CONSTRUCTION OF THE REVETMENT THE BANK SHALL BE SHAPED, COMPACTED, AND SLOPED TO A 1V:3 H SLOPE USING AS FILL. PREPARATION OF SLOPE IS AT NO ADDITIONAL COST TO THE GOVERNMENT.
 3. FILTER FABRIC SHALL BE PLACED BETWEEN THE CORE ROCK AND THE SAND FILL/EXISTING GROUND.
 4. THIS POINT IS LOCATED WHERE THE BOTTOM OF THE CORE ROCK LAYER INTERSECTS THE EXISTING GROUND.
 5. CORE ROCK MAXIMUM THICKNESS SHALL BE 2.0 FEET. SAND FILL SHALL BE USED TO FILL THE LAND WARD SIDE OF THE REVETMENT FROM THE ORIGINAL GROUND LINE UP TO THE BOTTOM OF THE CORE ROCK LAYER.

LEGEND

	"A" ROCK		CORE ROCK		MEGS		MATCH EXISTING GRADE SLOPES
	"B" ROCK		SAND		EXISTING CITY SEAWALL		

US ARMY CORPS OF ENGINEERS
ALASKA DISTRICT

CONTRACT NO. W911KB-07-R-0011
CONTRACTOR: [Signature]
CITY: ANCHORAGE
STATE: AK
DATE: 7/2/08

APR. 24, 2007
DESIGNED BY: J.E.F.
CHECKED BY: K. Esser
INVESTIGATOR: D. Harby
INV. NO. W911KB-07-R-0011
SH081818

SHISHMAREF & UNALAKLEET, ALASKA
ALASKA COASTAL EROSION
HYDRAULICS & HYDROLOGY
CIVIL WORKS
REVETMENT TYPICAL SECTIONS II

Reference number:
W-6
Sheet 7 of 11

AS-BLT



1. HORIZONTAL CONTROL IS ALASKA STATE PLANE, ZONE 7, NAD83(2003-00) IN U.S. SURVEY FEET HOLDING NATURAL RESOURCES CONSERVATION SERVICE CONTROL MONUMENT (NRCS 7) AS N 3,613,105.58, E 1,836,174.28, DETERMINED BY STATIC GPS OBSERVATIONS FROM CORS STATIONS BAY1, CENA, FAIR, KEN1, KOD1, TLKA, & TSEA.

2. VERTICAL CONTROL IS BASED ON U.S.C.&G.S. UNALAKLEET, ALASKA TIDAL BENCH MARK 946-833 D (1977), HAVING A VALUE OF 14.96 FEET MLLW DATUM.

3. NEAR SHORE BATHYMETRY WAS OBTAINED UTILIZING AN "CEESTAR DUAL FREQUENCY DIGITAL SURVEY ECHO SOUNDER" WITH A 3" TRANSDUCER INTERFACED WITH A "TRIMBLE 5800 GPS RTK" FOR REAL TIME POSITIONING AND TIDAL CORRECTORS. UPLAND CONTROL ESTABLISHED AND TOPOGRAPHY OBTAINED UTILIZING GPS RTK METHODOLOGY.

4. CONTOURS SHOWN ARE IN FEET MLLW.

5. THIS SURVEY REPRESENTS GENERAL CONDITIONS AT THE TIME OF SURVEY

STATION	NORTHING	EASTING	ELEV.	DESCRIPTION
SITE 1A	3,644,278.58	1,822,521.17	7.85	ALCAP
SITE 1B	3,643,412.17	1,820,020.84	7.53	ALCAP
SITE 2A	3,630,630.46	1,828,964.56	22.04	ALUM MON
NBA 2A	3,625,416.56	1,830,481.06	20.29	ALUM MON
SITE 3A	3,623,161.76	1,831,391.06	20.20	ALUM MON
SITE 3B	3,622,989.32	1,833,333.50	21.83	ALCAP
SITE 4A	3,609,981.32	1,834,741.62	11.77	ALCAP
LOT COR	3,608,814.27	1,836,160.84	16.46	ALCAP
83330	3,609,583.71	1,835,807.28	14.96	BRASS CAP
WCMC-1	3,611,906.95	1,834,154.61	16.77	ALUM MON
NRC5	3,612,226.07	1,834,933.55	19.61	ALUM MON

PT. 1	N	3611737.97	E	1834518.63	CORNER
PT. 2	N	3611928.60	E	1834457.51	CORNER
PT. 3	N	3612060.18	E	1834892.75	CORNER
PT. 4	N	3611996.61	E	183438.22	CORNER
PT. 5	N	3611795.33	E	1834697.53	CORNER
PT. 6	N	3612048.81	E	1834855.15	CORNER
PT. 7	N	3612383.42	E	1834754.00	CORNER
PT. 8	N	3612458.20	E	1835003.82	CORNER
PT. 9	N	3612246.35	E	1835068.17	CORNER
PT. 10	N	3612144.46	E	1834965.05	CORNER

1. THE CONTRACTOR SHALL COORDINATE WITH THE CITY OF UNALAKLEET CITY MANAGER FOR HAUL ROUTE, LOCAL ROAD RESTRICTIONS, AND EXISTING UTILITY LOCATES. ROCK STOCKPILES SHALL NOT ENCRANCH ON EXISTING UTILITIES, TRAIL TO THE CEMETERY, AND EXISTING STRUCTURES WITHIN THE STOCKPILE AREAS SHOWN.

2. THERE IS NO BARGE LANDING PROVIDED FOR THIS CONTRACT. THE CONTRACTOR SHALL BE RESPONSIBLE FOR ANY AND ALL ACTIVITIES REQUIRED TO DEVELOP AND/OR USE A BARGE LANDING SITE INCLUDING ANY PERMITTING REQUIREMENTS.

3. THE CONTRACTOR SHALL ERECT TEMPORARY ORANGE FABRIC CONSTRUCTION FENCING AROUND THE PERIMETER BOUNDARIES ON THE SIDES OF THE EXISTING CEMETERY. THE FENCING SHALL BE REMOVED UPON COMPLETION OF THE STOCKPILING OPERATION. THE FENCING SHALL EXCLUDE THE PORTION OF THE CEMETERY WITHIN THE STOCKPILE AREA SHOWN AND ROCK STOCKPILES SHALL NOT ENCRoACH ON THE EXISTING GRAVES.

DID NOT CONSTRUCT

UNALAKLEET

US ARMY CORPS
OF ENGINEERS
ALASKA DISTRICT

[illegible]

CONTRACTOR ARRIGALLI JV

CITY ANCHORAGE STATE AK

Recommended:	Approved:	Date:
<i>[Signature]</i>	<i>[Signature]</i>	2/2/00

APR. 24, 2007

Study Status AS NOTED

Net Gender 1:1

Red Boxes 1:1

SH081818-08-W-7
6-SH-154-32-02

[illegible]

U.S. ARMY ENGINEER DISTRICT

CORPS OF ENGINEERS
ANCHORAGE, ALASKACORPS OF ENGINEERS
ANCHORAGE, ALASKA[illegible]

SHISHMAROFF & UNIAKIKET ALASKA

SHISHIMAREF & UNALAKLEET, ALASKA

ALASKA COASTAL EROSION

ALASKA COASTAL EROSION

HYDRAULICS & HYDROLOGY
CIVIL WORKS


Reference
number:

W-7

Sheet 8 of 11

A B C D E F G H

6
5
4
3
2
1

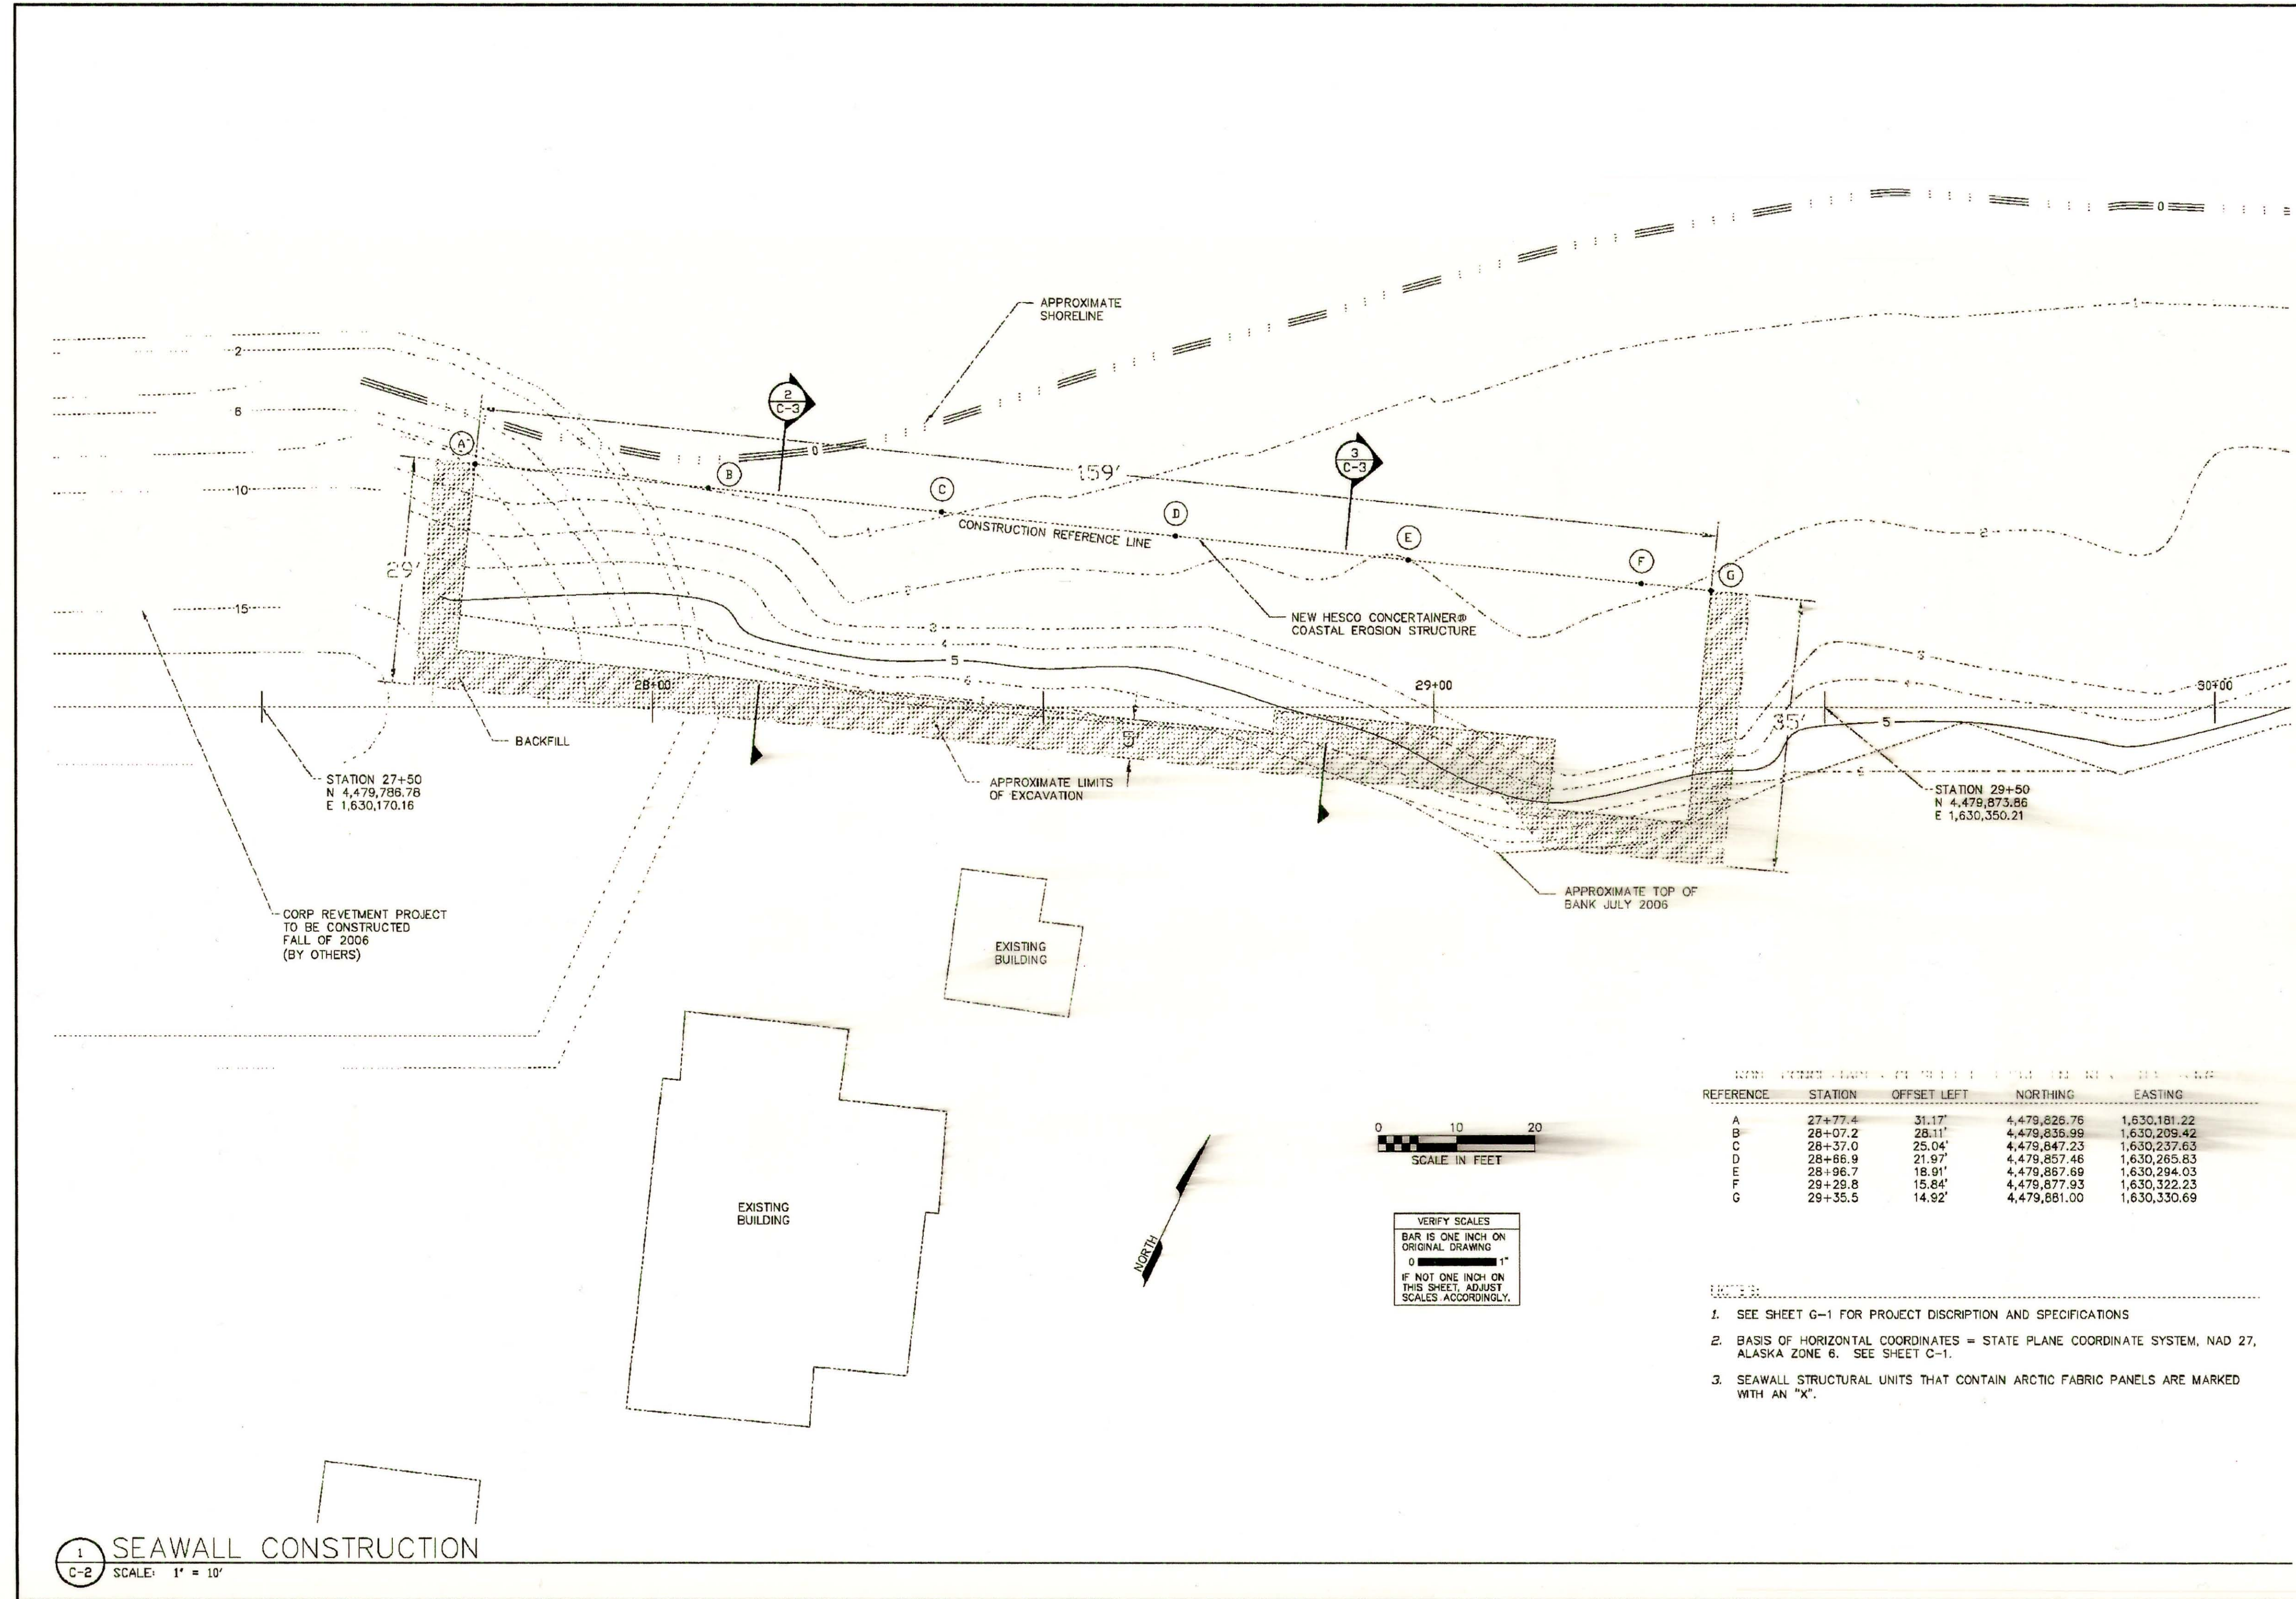

CITY OF SHISHMARF

COASTAL EROSION CONTROL PILOT PROJECT
SHISHMARF, ALASKA

LCMF LLC
401 E. 6th Ave. Suite 205 Anchorage, Alaska 99501-2005

CONSTRUCTION DRAWINGS

SEAWALL CONSTRUCTION
C-2

US ARMY CORPS
OF ENGINEERS
ALASKA DISTRICT

CONTRACT NO. W911KB-07-C-0022
CONTRACTOR ARBUCAH JV
CITY ANCHORAGE
STATE AK
PROJECT NUMBER 24462
DATE 2/4/07

Rev.	Description	Date	Appr.
1	Issue for Construction	2/4/07	

Date	Drawn	Check	Plot	File
24 APR 2007	AS	AS	AS	SHI081818-09-W-8

NO. W911KB-07-R-0011
SHI081818


SHISHMARF & UNALAKLEET, ALASKA
ALASKA COASTAL EROSION
HYDRAULICS & HYDROLOGY
CIVIL WORKS
EXHIBIT I

Reference number:
W-8
Sheet 9 of 11


THIS DRAWING IS NOT TO SCALE AND IS PROVIDED FOR INFORMATIONAL PURPOSES ONLY.

EXHIBIT I


AS-BLT

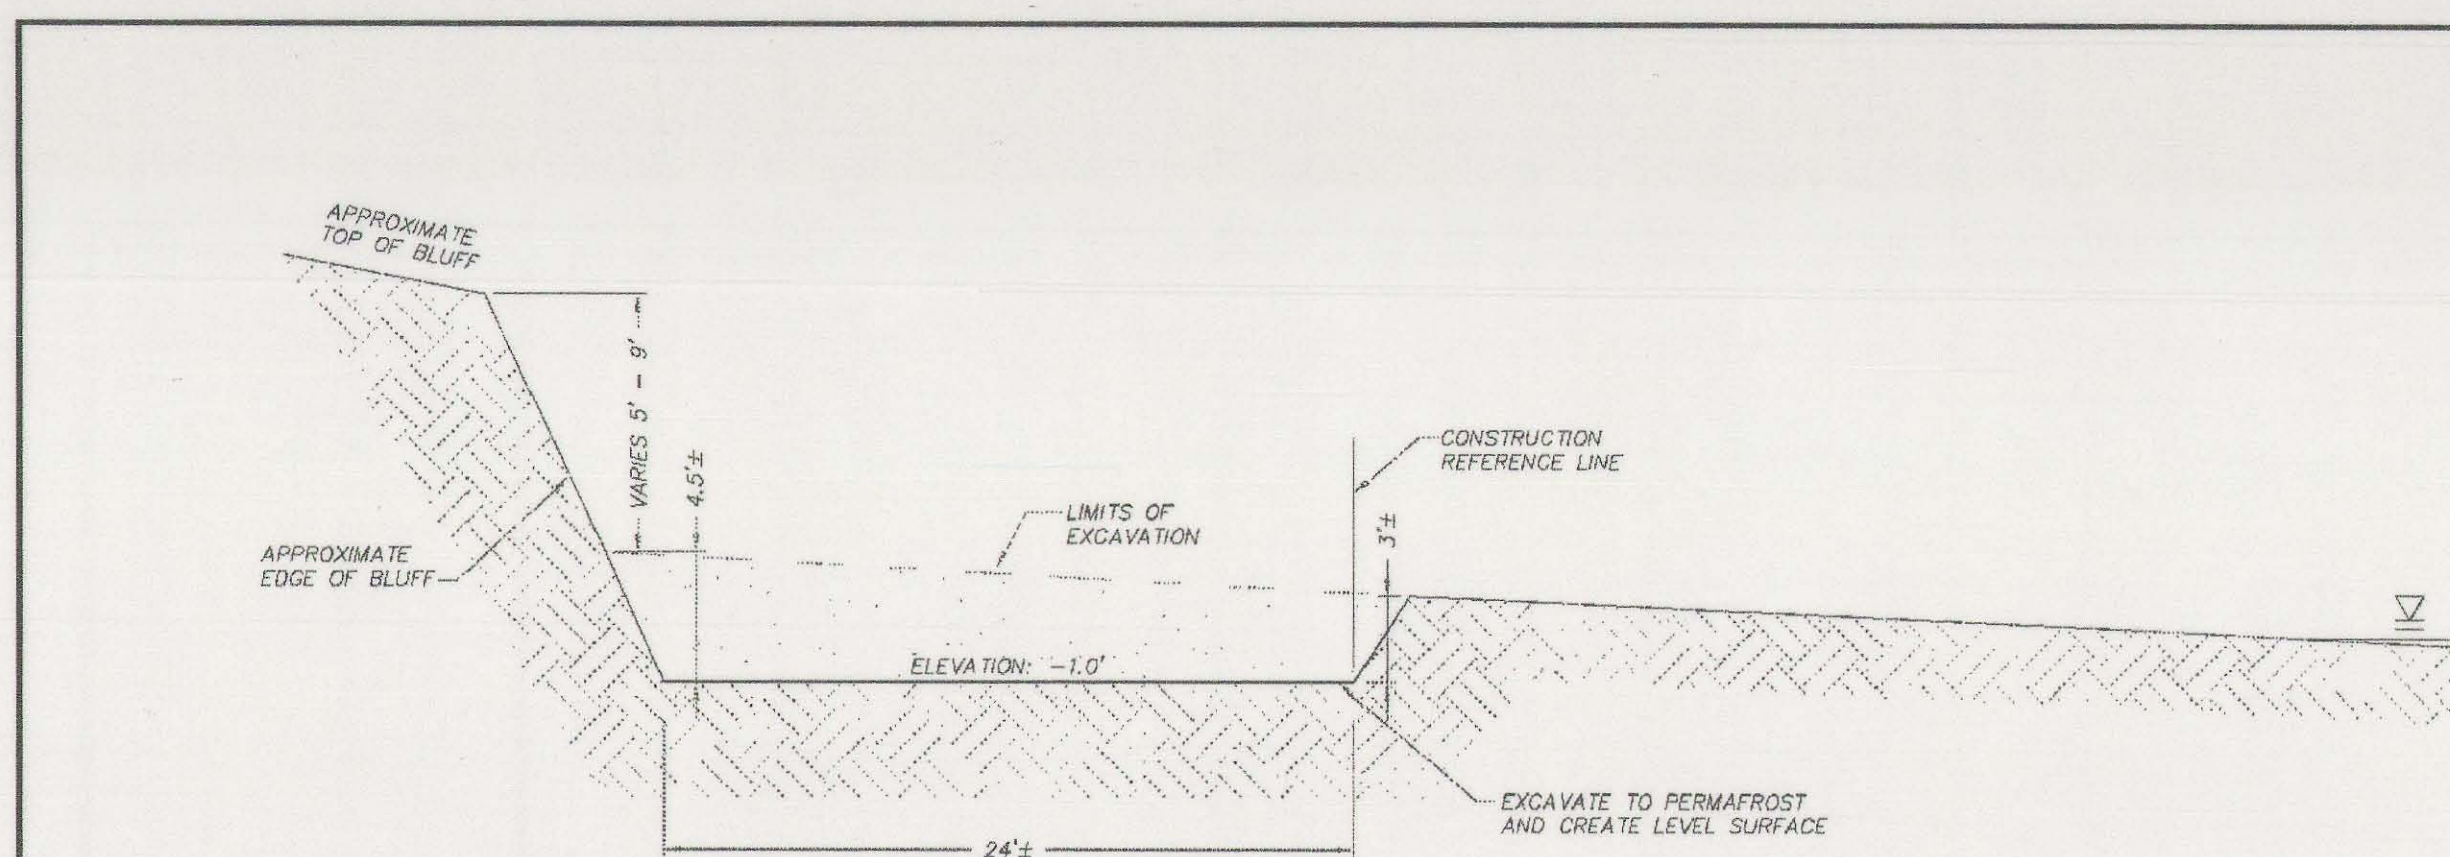

1 EXCAVATION SECTION
C-3 SCALE: 1" = 5'

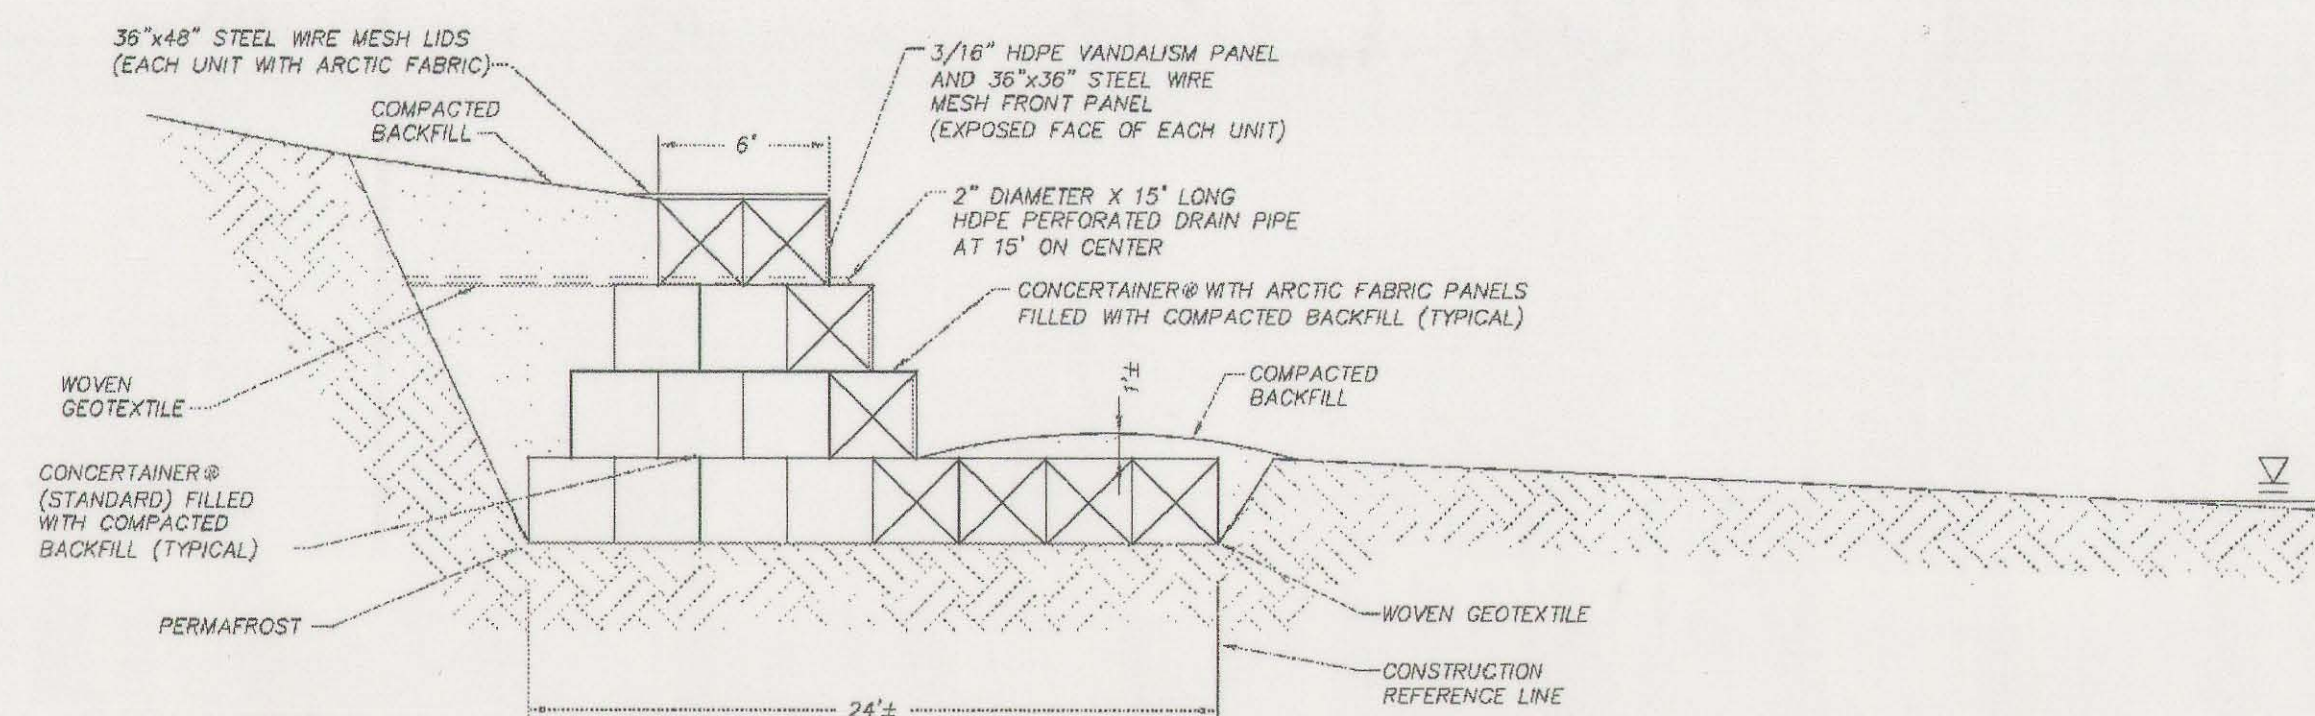


2 FOUR TIER SEAWALL-SECTION
C-3 SCALE: 1" = 5'

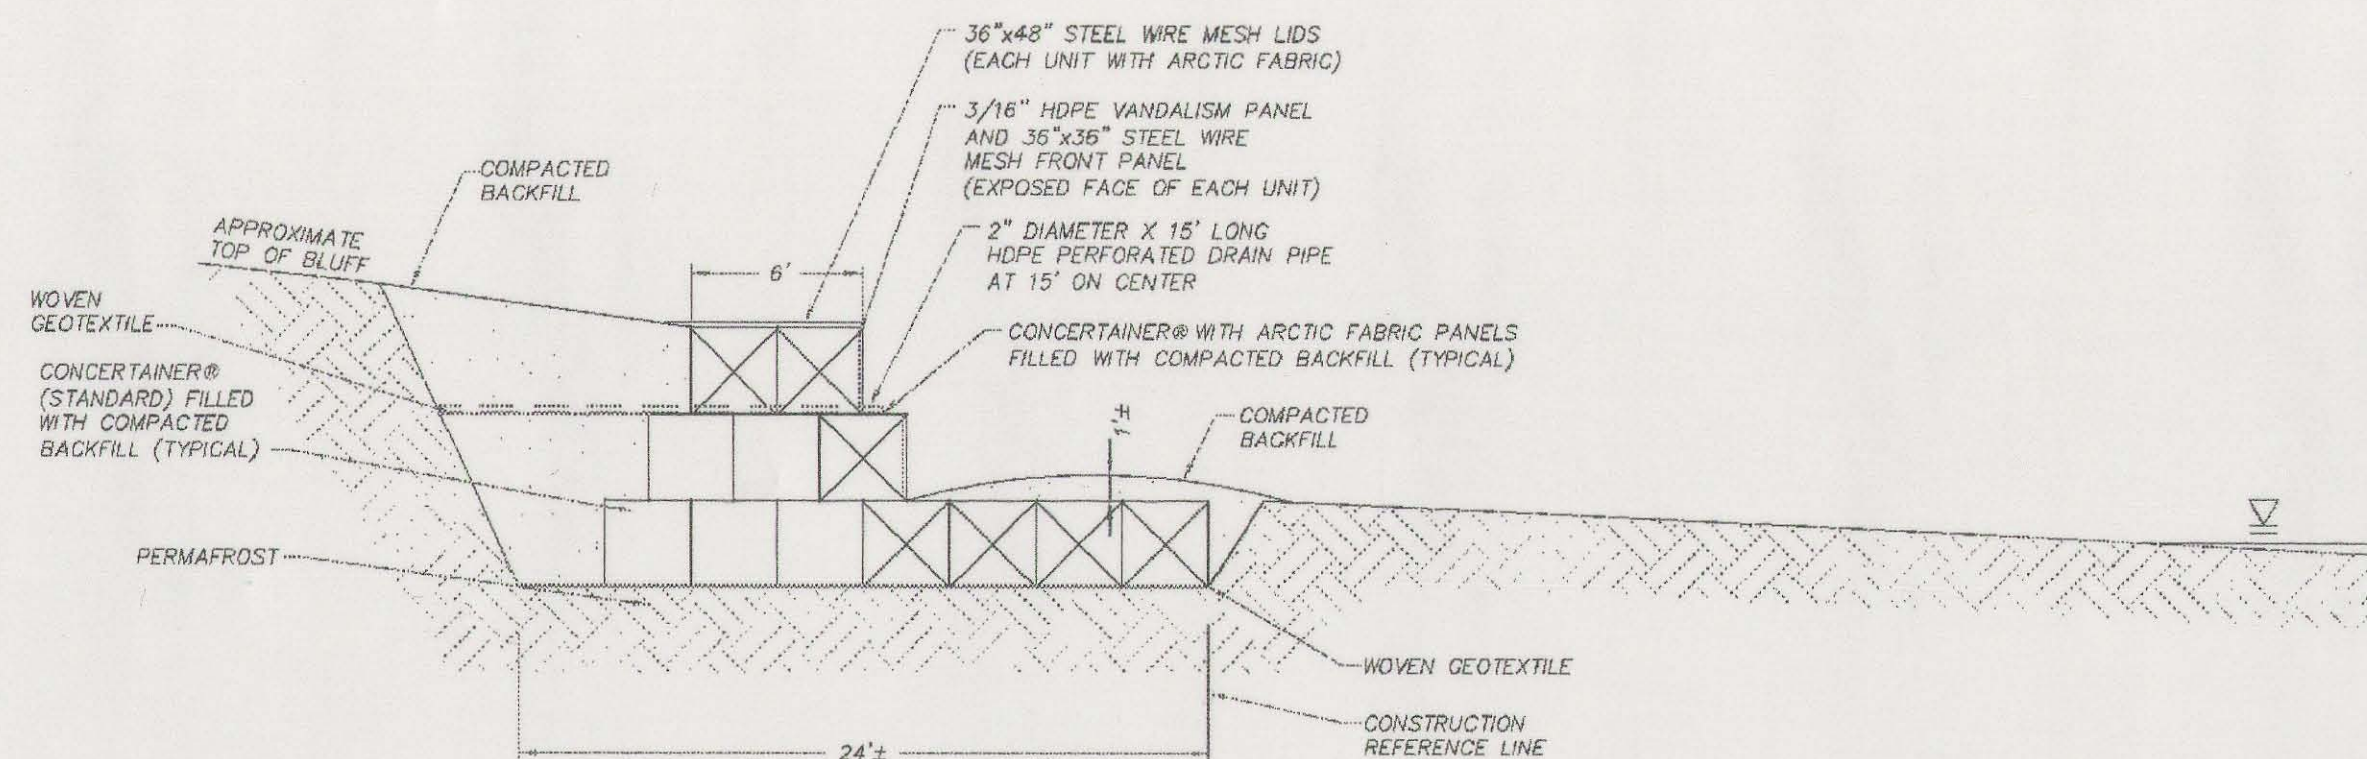


3 THREE TIER SEAWALL-SECTION
C-3 SCALE: 1" = 5'

- NOTES
1. SEE SHEET G-1 FOR PROJECT DESCRIPTION AND SPECIFICATIONS.
 2. PLACE 2" x 15' LONG SCHEDULE 80 HDPE PERFORATED DRAIN PIPE BETWEEN THIRD TIER AND TOP TIER AT 15 FEET ON CENTER.
 3. COMPACT SUBGRADE AND BACKFILL TO 90% MAXIMUM DENSITY.
 4. INSTALL 3/16" HDPE VANDALISM PANEL AND 36"x36" STEEL WIRE MESH FRONT AT THE EXPOSED FACE OF EACH UNIT.

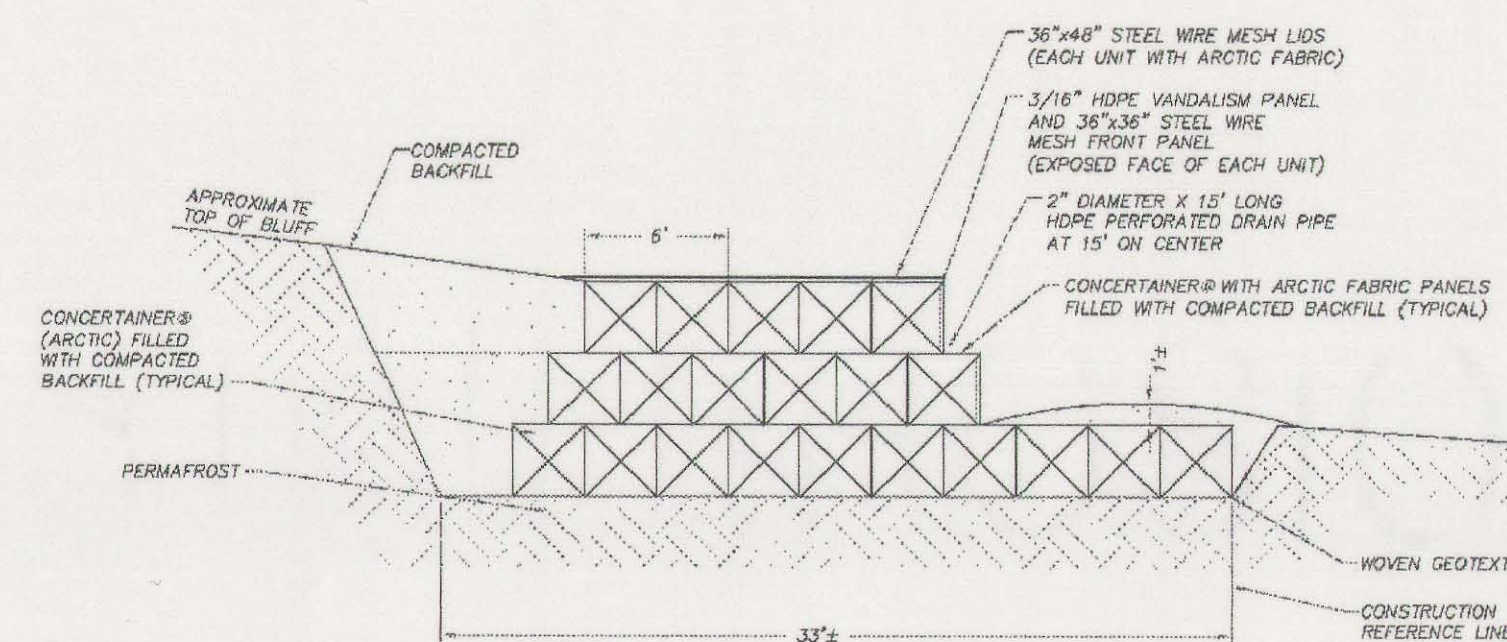

4 SEAWALL TERMINATION SECTION
C-3 SCALE: 1" = 6'

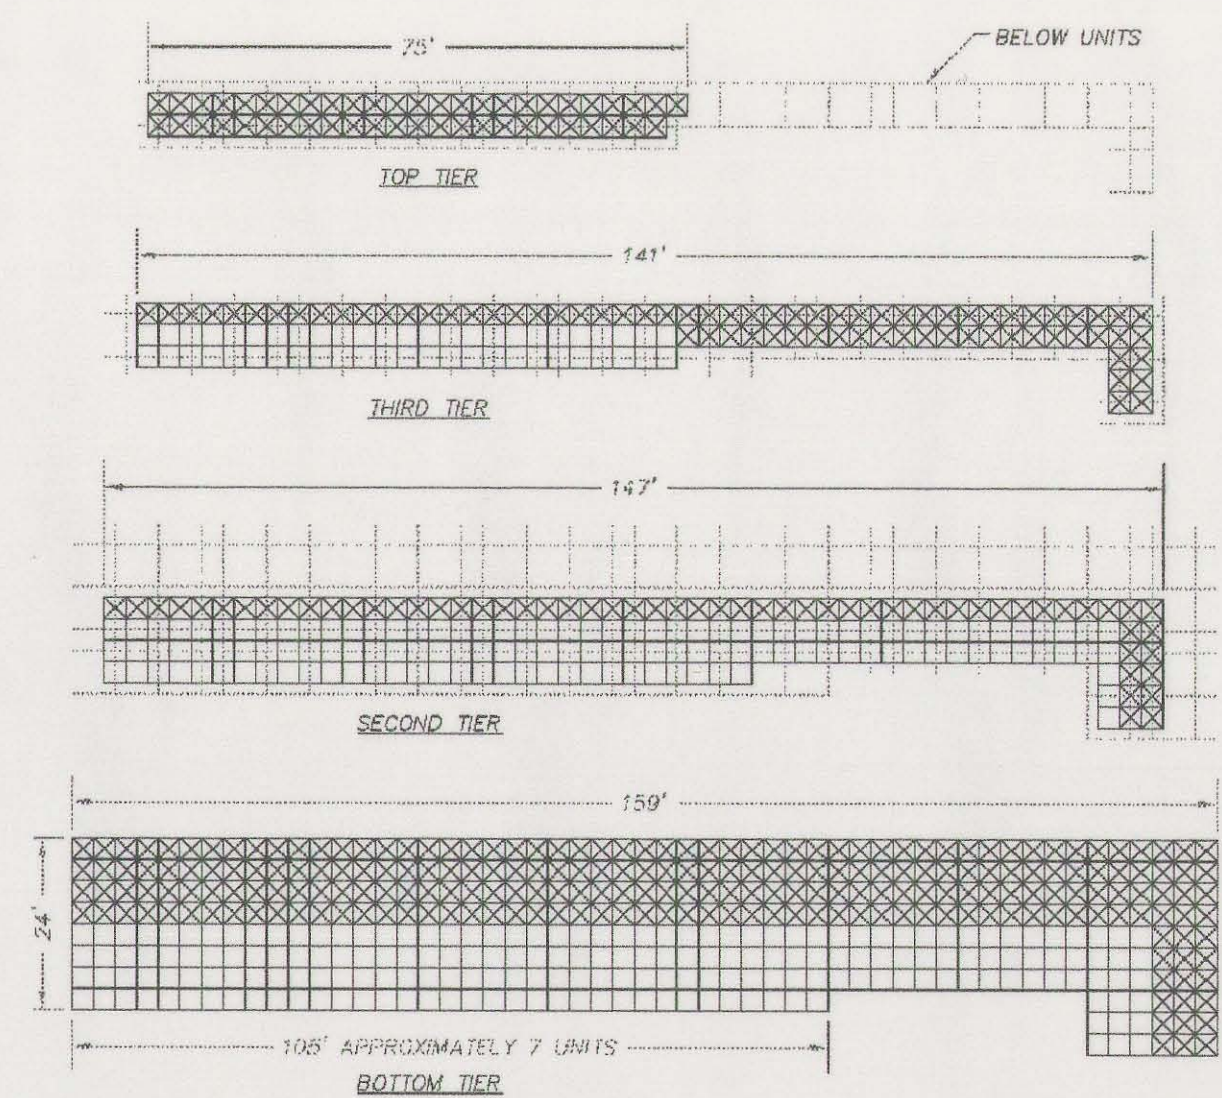

5 SEAWALL TIER PLAN VIEW
C-3 SCALE: 1" = 20'

THIS DRAWING IS NOT TO SCALE AND IS PROVIDED FOR INFORMATIONAL PURPOSES ONLY.

EXHIBIT III

AS-BLT