


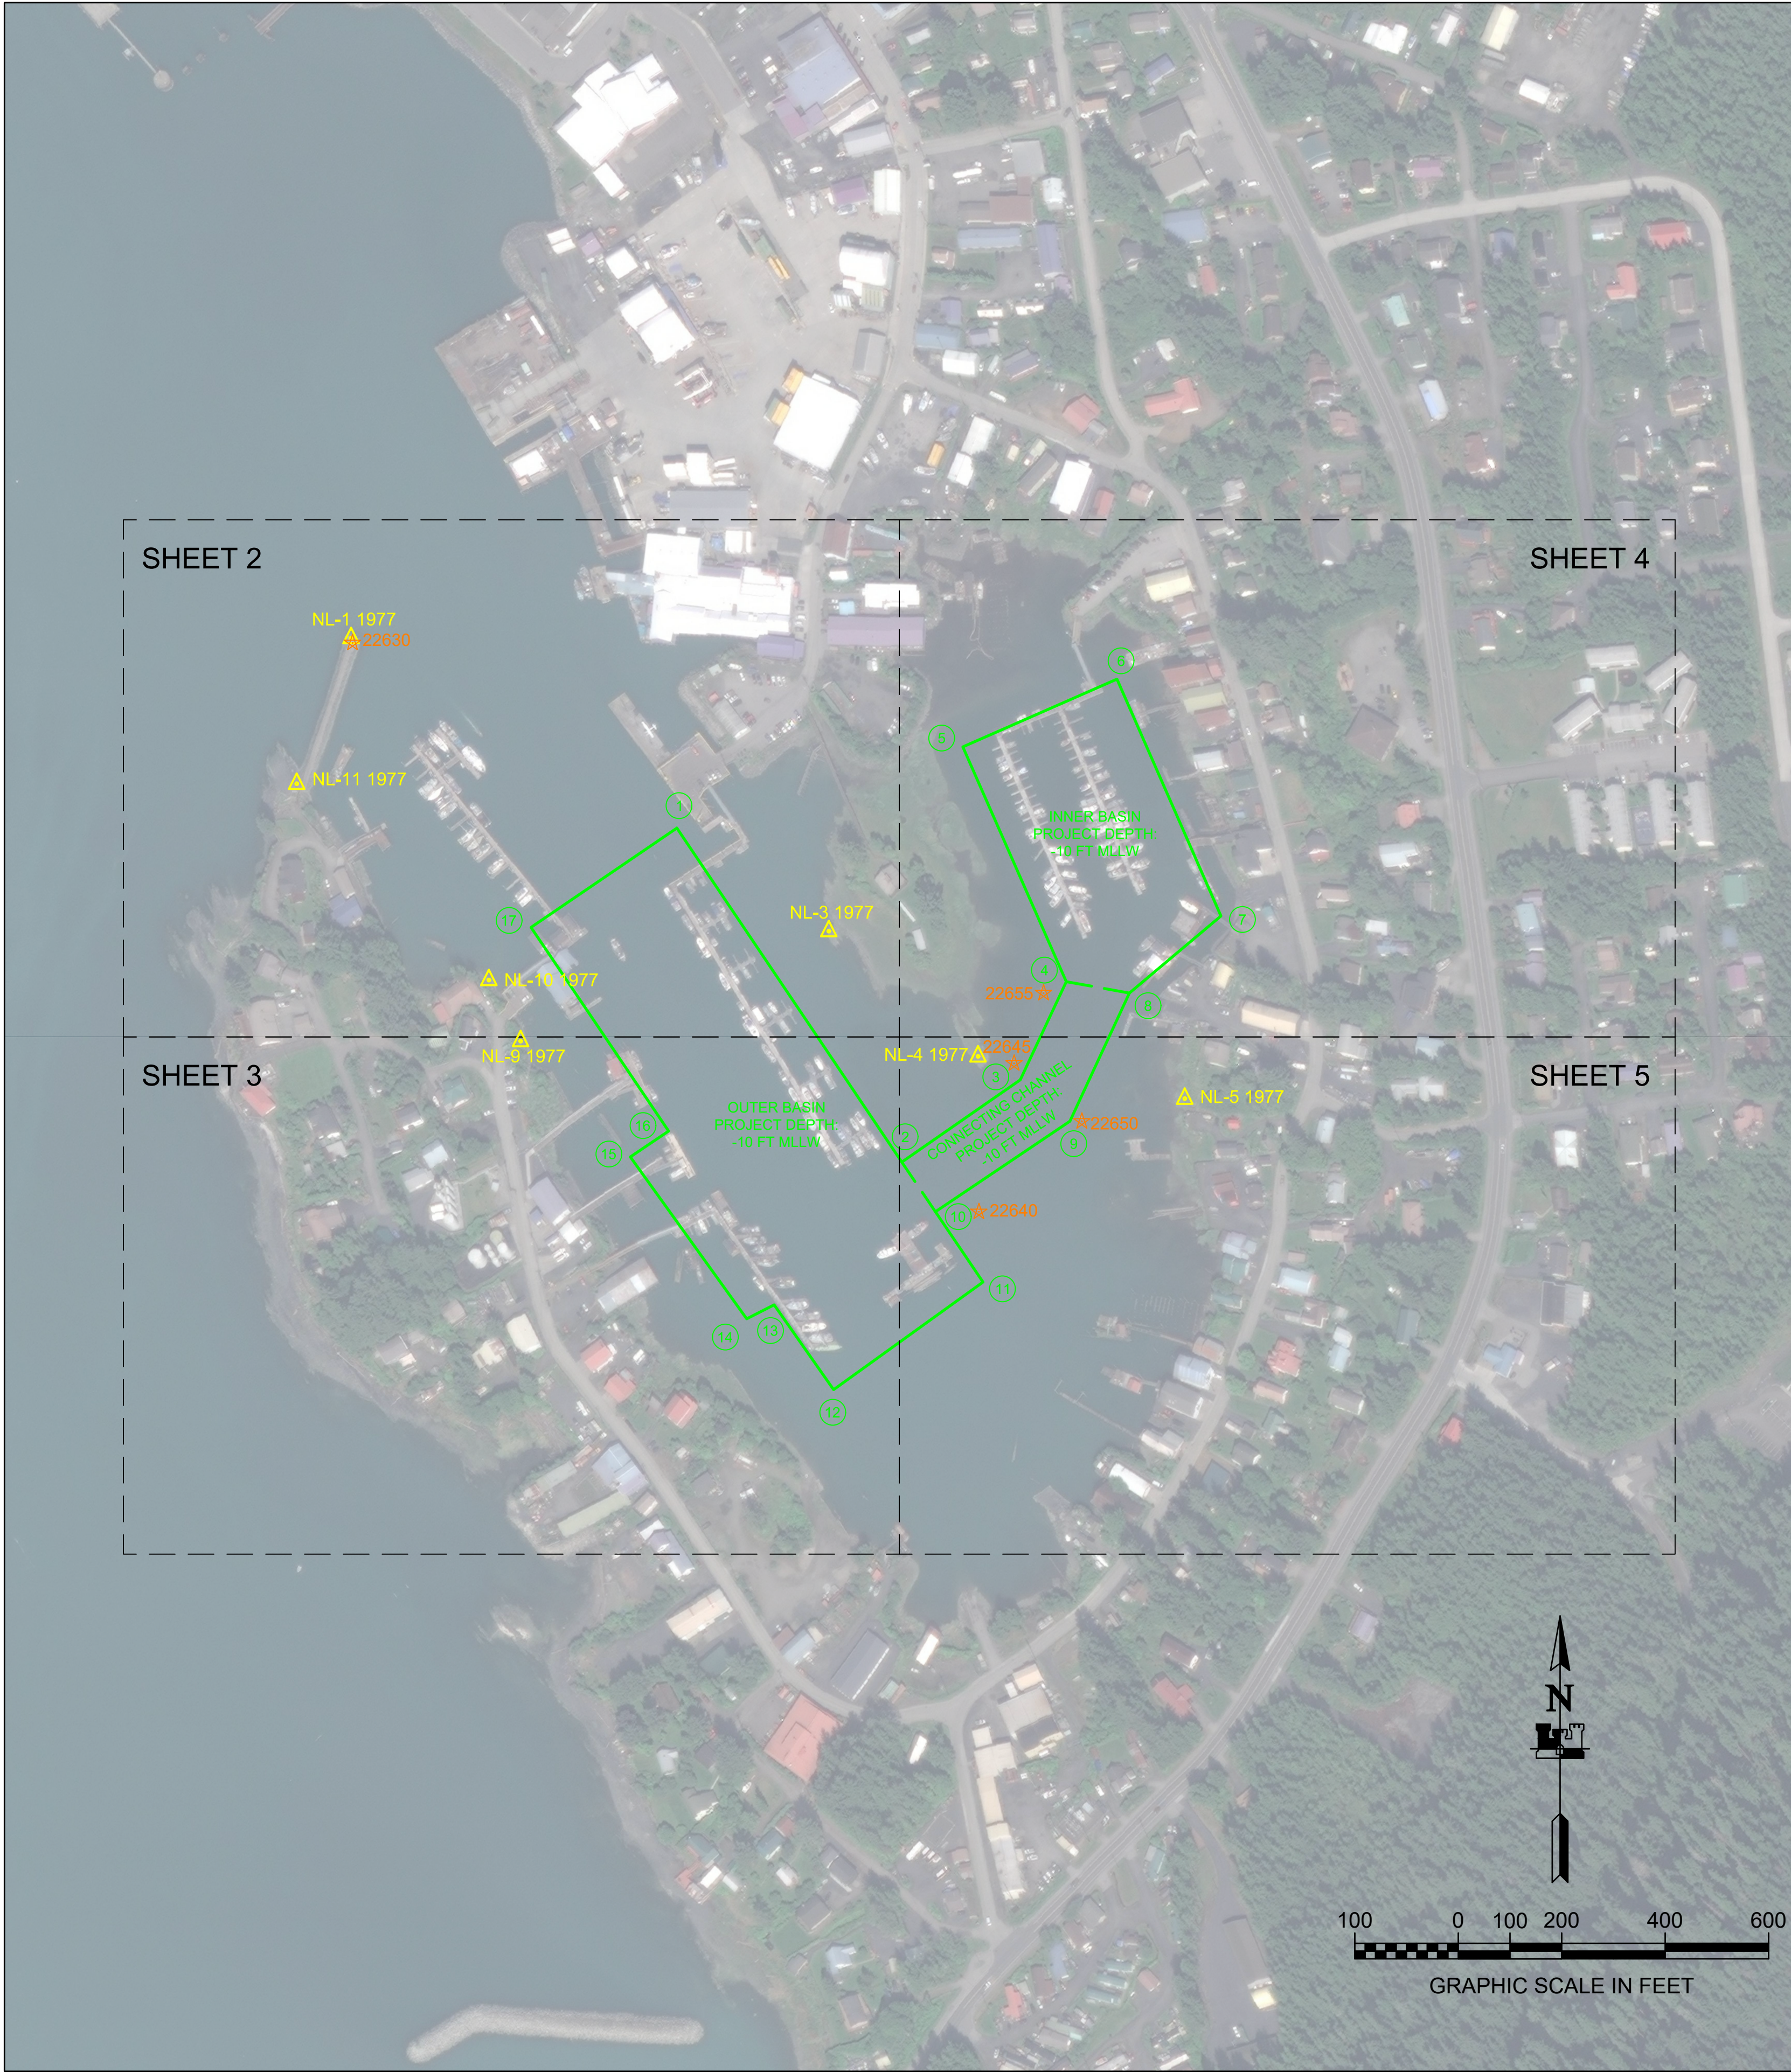

NAVIGATION AIDS			
NO.	NORTHING	EASTING	DESCRIPTION
22630	1,694,512	2,944,943	BREAKWATER LIGHT 2 FI R 4S
22640	1,693,412	2,946,154	DAYBEACON 4
22645	1,693,699	2,946,222	DAYBEACON 5
22650	1,693,587	2,946,353	DAYBEACON 6
22655	1,693,835	2,946,279	DAYBEACON 7

PROJECT LIMITS			PROJECT LIMITS		
CORNER#	NORTHING	EASTING	CORNER#	NORTHING	EASTING
1	1,694,154.00	2,945,570.00	10	1,693,412.00	2,946,070.00
2	1,693,508.00	2,946,005.00	11	1,693,276.00	2,946,162.00
3	1,693,667.00	2,946,234.00	12	1,693,068.00	2,945,873.00
4	1,693,857.00	2,946,323.00	13	1,693,232.00	2,945,758.00
5	1,694,311.00	2,946,123.00	14	1,693,205.00	2,945,705.00
6	1,694,442.00	2,946,421.00	15	1,693,518.00	2,945,480.00
7	1,693,984.00	2,946,622.00	16	1,693,568.00	2,945,554.00
8	1,693,835.00	2,946,445.00	17	1,693,962.00	2,945,288.00
9	1,693,587.00	2,946,330.00			

VOLUME COMPUTATIONS		
AREA A: OUTER BASIN	MLLW=0	CU. YD.
AVAILABLE TO PROJECT DEPTH (PD)	-10.0	2,226
AVAILABLE TO MAX PAY DEPTH (MP)	-11.0	5,880
AVAILABLE SIDE SLOPES (SS) AT 3:1 (H:V) & 25' WIDE	VARIES	1,140
AREA B: CONNECTING CHANNEL		
AVAILABLE TO PD	-10.0	116
AVAILABLE TO MP	-11.0	284
AVAILABLE SS AT 3:1 (H:V) & 25' WIDE	VARIES	709
AREA C: INNER BASIN		
AVAILABLE TO PD	-10.0	1,519
AVAILABLE TO MP	-11.0	4,147
AVAILABLE SS AT 3:1 (H:V) & 25' WIDE	VARIES	1,938
TOTAL MAXIMUM VOLUME AVAILABLE (MP + SS)		14,098

LEGEND

CULVERT	<
CATCH BASIN	☒
VALVE OR VALVE CONNECTION	⊗
SIGN	○
ELECTRICAL PEDESTAL	⊞
ELECTRICAL PEDESTAL WITH LIGHT	⊞⊕
ELECTRICAL SWITCH	⊞
LIGHT POLE	○⊕
POWER POLE WITH LIGHT	●⊕
POWER POLE	●
BUILDING	▧



THIS HYDROGRAPHIC SURVEY WAS COMPLETED UNDER THE OVERSIGHT OF AN NSPS/THSOA CERTIFIED HYDROGRAPHER

Gregory W. Gibson (317)




NOTES

- PRIMARY PROJECT HORIZONTAL CONTROL IS ALASKA STATE PLANE, ZONE 1, NAD83 (2011) 2010.00, IN US SURVEY FEET BASED ON A FULLY CONSTRAINED STATIC GPS NETWORK HOLDING THE PUBLISHED NAD83 2003.00 EPOCH VALUES OF NGS CORS STATIONS: "KLAWOCKAIRAK2006 CORS ARP" (PID DM7451); "LEV6 LEVEL ISLAND 6 CORS ARP" (PID DJ3035); "A1S5 ANNETTE ISLAND 5 CORS ARP" (PID DK6482).

LOCAL PROJECT HORIZONTAL CONTROL IS ALASKA STATE PLANE, ZONE 1, NAD83, IN U.S. SURVEY FEET HOLDING USACE DOMED SBC "HH-5 2015" AS N 1,690,528.07', E 2,945,715.80'.
- VERTICAL CONTROL IS MEAN LOWER LOW WATER (MLLW=0.0'), BASED ON THE NOAA/NOS TIDAL BENCH MARK LIST "9451204 WRANGELL, WRANGELL ISLAND, ALASKA", PUBLISHED 7/15/2004. THIS TIDAL DATUM IS BASED ON THE 1983-2001 TIDAL EPOCH AND IS REFERENCED BY HOLDING NOAA/NOS TIDAL BENCH MARK "945 1204 BM 5" (PID BBDG97 / VM#16496) AS 57.71'.
- VERTICAL TIES TO THE NATIONAL SPATIAL REFERENCE SYSTEM ARE BASED ON PUBLISHED NAVD83 (GEOID 12B) ELEVATIONS HOLDING NOAA/NOS TIDAL BENCH MARK "945 1204 BM 5" (PID BBDG97 / VM#16496) AS 54.46'.
- SOUNDINGS ARE IN FEET AND ARE MINUS UNLESS OTHERWISE INDICATED.
- BATHYMETRY WAS COLLECTED AUGUST 10-13, 2019. SOUNDINGS WERE COLLECTED USING AN R2SONIC 2020 MULTIBEAM ECHOSOUNDER OPERATING AT 400 KHZ. SOUND VELOCITY THOUGH THE WATER COLUMN WAS DETERMINED WITH A AML BASE X SOUND VELOCITY PROBE. POSITION AND VESSEL ORIENTATION WERE MEASURED USING AN APPLANIX POSMV WAVEMASTER V5 SYSTEM RECEIVING RTK CORRECTIONS FROM A TRIMBLE R8 MODEL 3 GPS RECEIVER SET AT CONTROL STATION "HH-5 2015". DATA WAS COLLECTED AND PROCESSED USING QINSY 8.1 AND QIMERA 1.6 SOFTWARE. HORIZONTAL CONTROL WAS VERIFIED USING RTK GNSS EQUIPMENT AND TECHNIQUES. VERTICAL CONTROL WAS SURVEYED USING DIFFERENTIAL LEVELING TECHNIQUES.
- TERRESTIAL LASER SCANNING DATA WAS COLLECTED AUGUST 10-13, 2019. DATA WAS COLLECTED USING A RIEGL VZ400 LASER SCANNER AND PROCESSED USING QINSY 8.1 AND QIMERA 1.6 SOFTWARE. POSITION AND VESSEL ORIENTATION WERE MEASURED USING AN APPLANIX POSMV WAVEMASTER V5 SYSTEM.
- THIS DRAWING INDICATES GENERAL CONDITIONS AT THE TIME OF THE SURVEY.
- MAP SOUNDINGS ARE BINNED AT 24 FEET AND ARE SHOAL-BIASED. CONTOURS ARE BASED ON 12 FEET BINNED SHOAL-BIASED SOUNDINGS. VOLUME SOUNDINGS ARE BINNED AT 3 FEET AND ARE MEAN VALUE SOUNDINGS.

SURVEY CONTROL DATA				
STATION	NORTHING	EASTING	MLLW	DESCRIPTION
1204 BM 5	1,696,448.86	2,945,337.04	57.71	3.75 INCH SBC
HH-5 2015	1,690,528.07	2,945,715.80	24.98	3.5 INCH USACE DOMED SBC
LARGE-2 1922	1,683,964.45	2,925,896.83	21.2	3.5 INCH USCGS DOMED SBC
NL-1 1977	1,694,521.22	2,944,940.27	14.66	3.5 INCH USACE DOMED SBC
NL-3 1977	1,693,954.53	2,945,863.80	13.46	3.5 INCH USACE DOMED SBC
NL-4 1977	1,693,712.40	2,946,152.17	14.29	3.5 INCH USACE DOMED SBC
NL-5 1977	1,693,630.72	2,946,551.87	14.46	3.5 INCH USACE DOMED SBC
NL-9 1977	1,693,741.95	2,945,267.89	15.83	3.5 INCH USACE DOMED SBC
NL-10 1977	1,693,860.13	2,945,206.54	14.10	3.5 INCH USACE DOMED SBC
NL-11 1977	1,694,239.54	2,944,835.11	20.15	3.5 INCH USACE DOMED SBC
NO 6 1954	1,696,366.66	2,944,512.60	40.27	3.5 INCH USCGS DOMED SBC

*Bench marks with coordinate precision of 0.1' were measured by RTK GNSS.

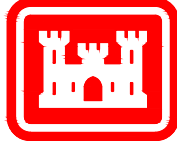


US ARMY CORPS OF ENGINEERS® ALASKA DISTRICT

REV.	DATE	BY	APPR.	DESCRIPTION


 U.S. ARMY CORPS OF ENGINEERS ALASKA DISTRICT 2204 3RD STREET BER, ALASKA 99506-0888	SURVEYED BY: GREGORY W. GIBSON	UPC: 021500	CONTRACT NO.: WB11K-16-D-0014		
			TASK ORDER NO.: 19PD064		
			PLOT DATE: 07 October 2019		
			JOB NO.: 119		
U.S. ARMY CORPS OF ENGINEERS ALASKA DISTRICT 2204 3RD STREET BER, ALASKA 99506-0888	DRAWN BY: ROBERT GOUGHNOUR	CHECKED BY: TASJGGG	SCALE: 1" = 200'	JOB NO.: 119	
U.S. ARMY CORPS OF ENGINEERS ALASKA DISTRICT 2204 3RD STREET BER, ALASKA 99506-0888	APPROVED BY: TASJGGG	FILE: 021500_VH02.DWG	STATE: ALASKA		
			CITY: WASILLA		
			SECTION: LEVER INC.		
			CHIEF GEOMATICS SECTION: LEVER INC.		

WRANGELL, ALASKA
021500 - WRANGELL HARBOR
PROJECT CONDITION SURVEY
AUGUST 8 - AUGUST 14, 2019

REFERENCE NUMBER: 1-WRA-92-07-56
SHEET 1 OF 6

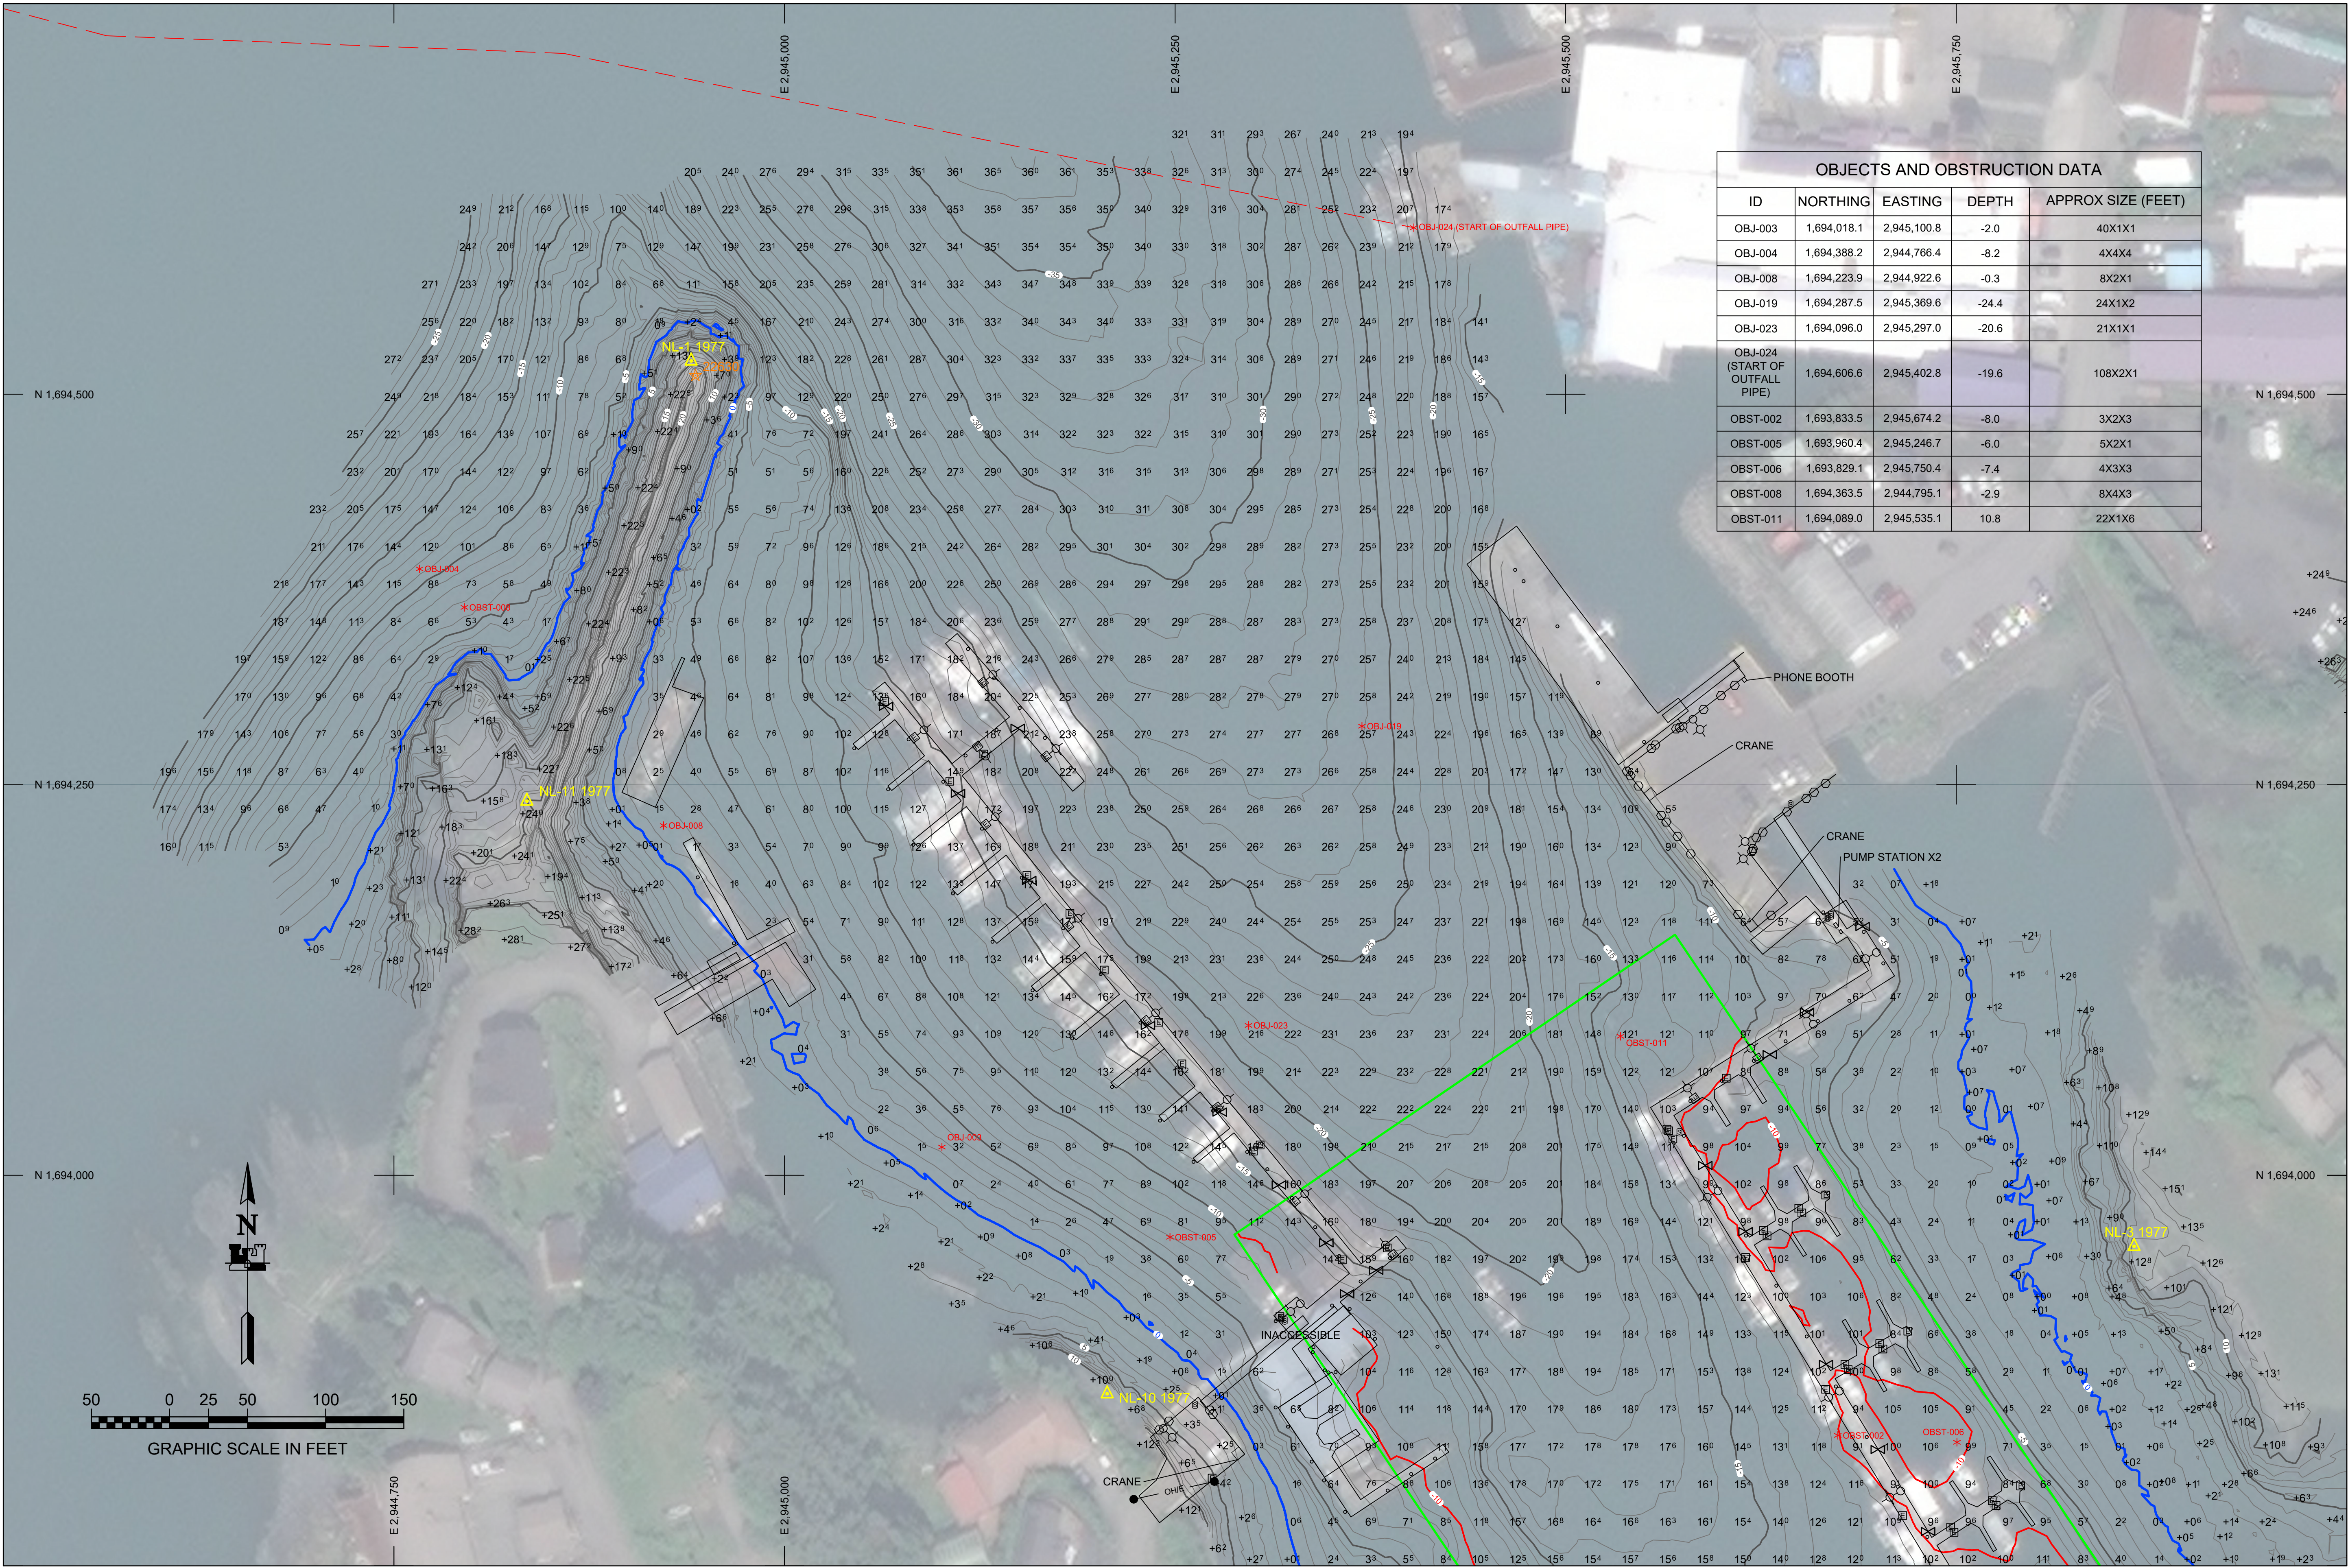

OBJECTS AND OBSTRUCTION DATA				
ID	NORTHING	EASTING	DEPTH	APPROX SIZE (FEET)
OBJ-003	1,694,018.1	2,945,100.8	-2.0	40X1X1
OBJ-004	1,694,388.2	2,944,766.4	-8.2	4X4X4
OBJ-008	1,694,223.9	2,944,922.6	-0.3	8X2X1
OBJ-019	1,694,287.5	2,945,369.6	-24.4	24X1X2
OBJ-023	1,694,096.0	2,945,297.0	-20.6	21X1X1
OBJ-024 (START OF OUTFALL PIPE)	1,694,606.6	2,945,402.8	-19.6	108X2X1
OBST-002	1,693,833.5	2,945,674.2	-8.0	3X2X3
OBST-005	1,693,960.4	2,945,246.7	-6.0	5X2X1
OBST-006	1,693,829.1	2,945,750.4	-7.4	4X3X3
OBST-008	1,694,363.5	2,944,795.1	-2.9	8X4X3
OBST-011	1,694,089.0	2,945,535.1	10.8	22X1X6

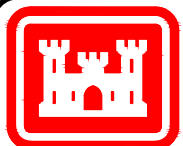

US ARMY CORPS
OF ENGINEERS®
ALASKA DISTRICT

REV.	DATE	BY	APPR.	DESCRIPTION


U.S. ARMY CORPS OF ENGINEERS ALASKA DISTRICT 224 3RD STREET BER ALASKA 99504-0888	SURVEYED BY: GREGORY W. GIBSON		UPC: 021500	CONTRACT NO.: W811KG-16-D-0014	
	DRAWN BY: ROBERT GOUGHNOUR		PLOT DATE: 07 October 2019	TASK ORDER NO.: 19PD064	
	CHECKED BY: TASISGGV		ANSI D 1:1 = 50'	JOB NO.: 119	
	APPROVED BY: THOMAS SLOAN, CHIEF GEOMATICS SECTION		FILE: 021500_VH02.DWG	STATE: ALASKA	

WRANGELL, ALASKA
021500 - WRANGELL HARBOR
PROJECT CONDITION SURVEY
AUGUST 8 - AUGUST 14, 2019


REFERENCE
NUMBER:

1-WRA-92-07-56

SHEET 2 OF 6

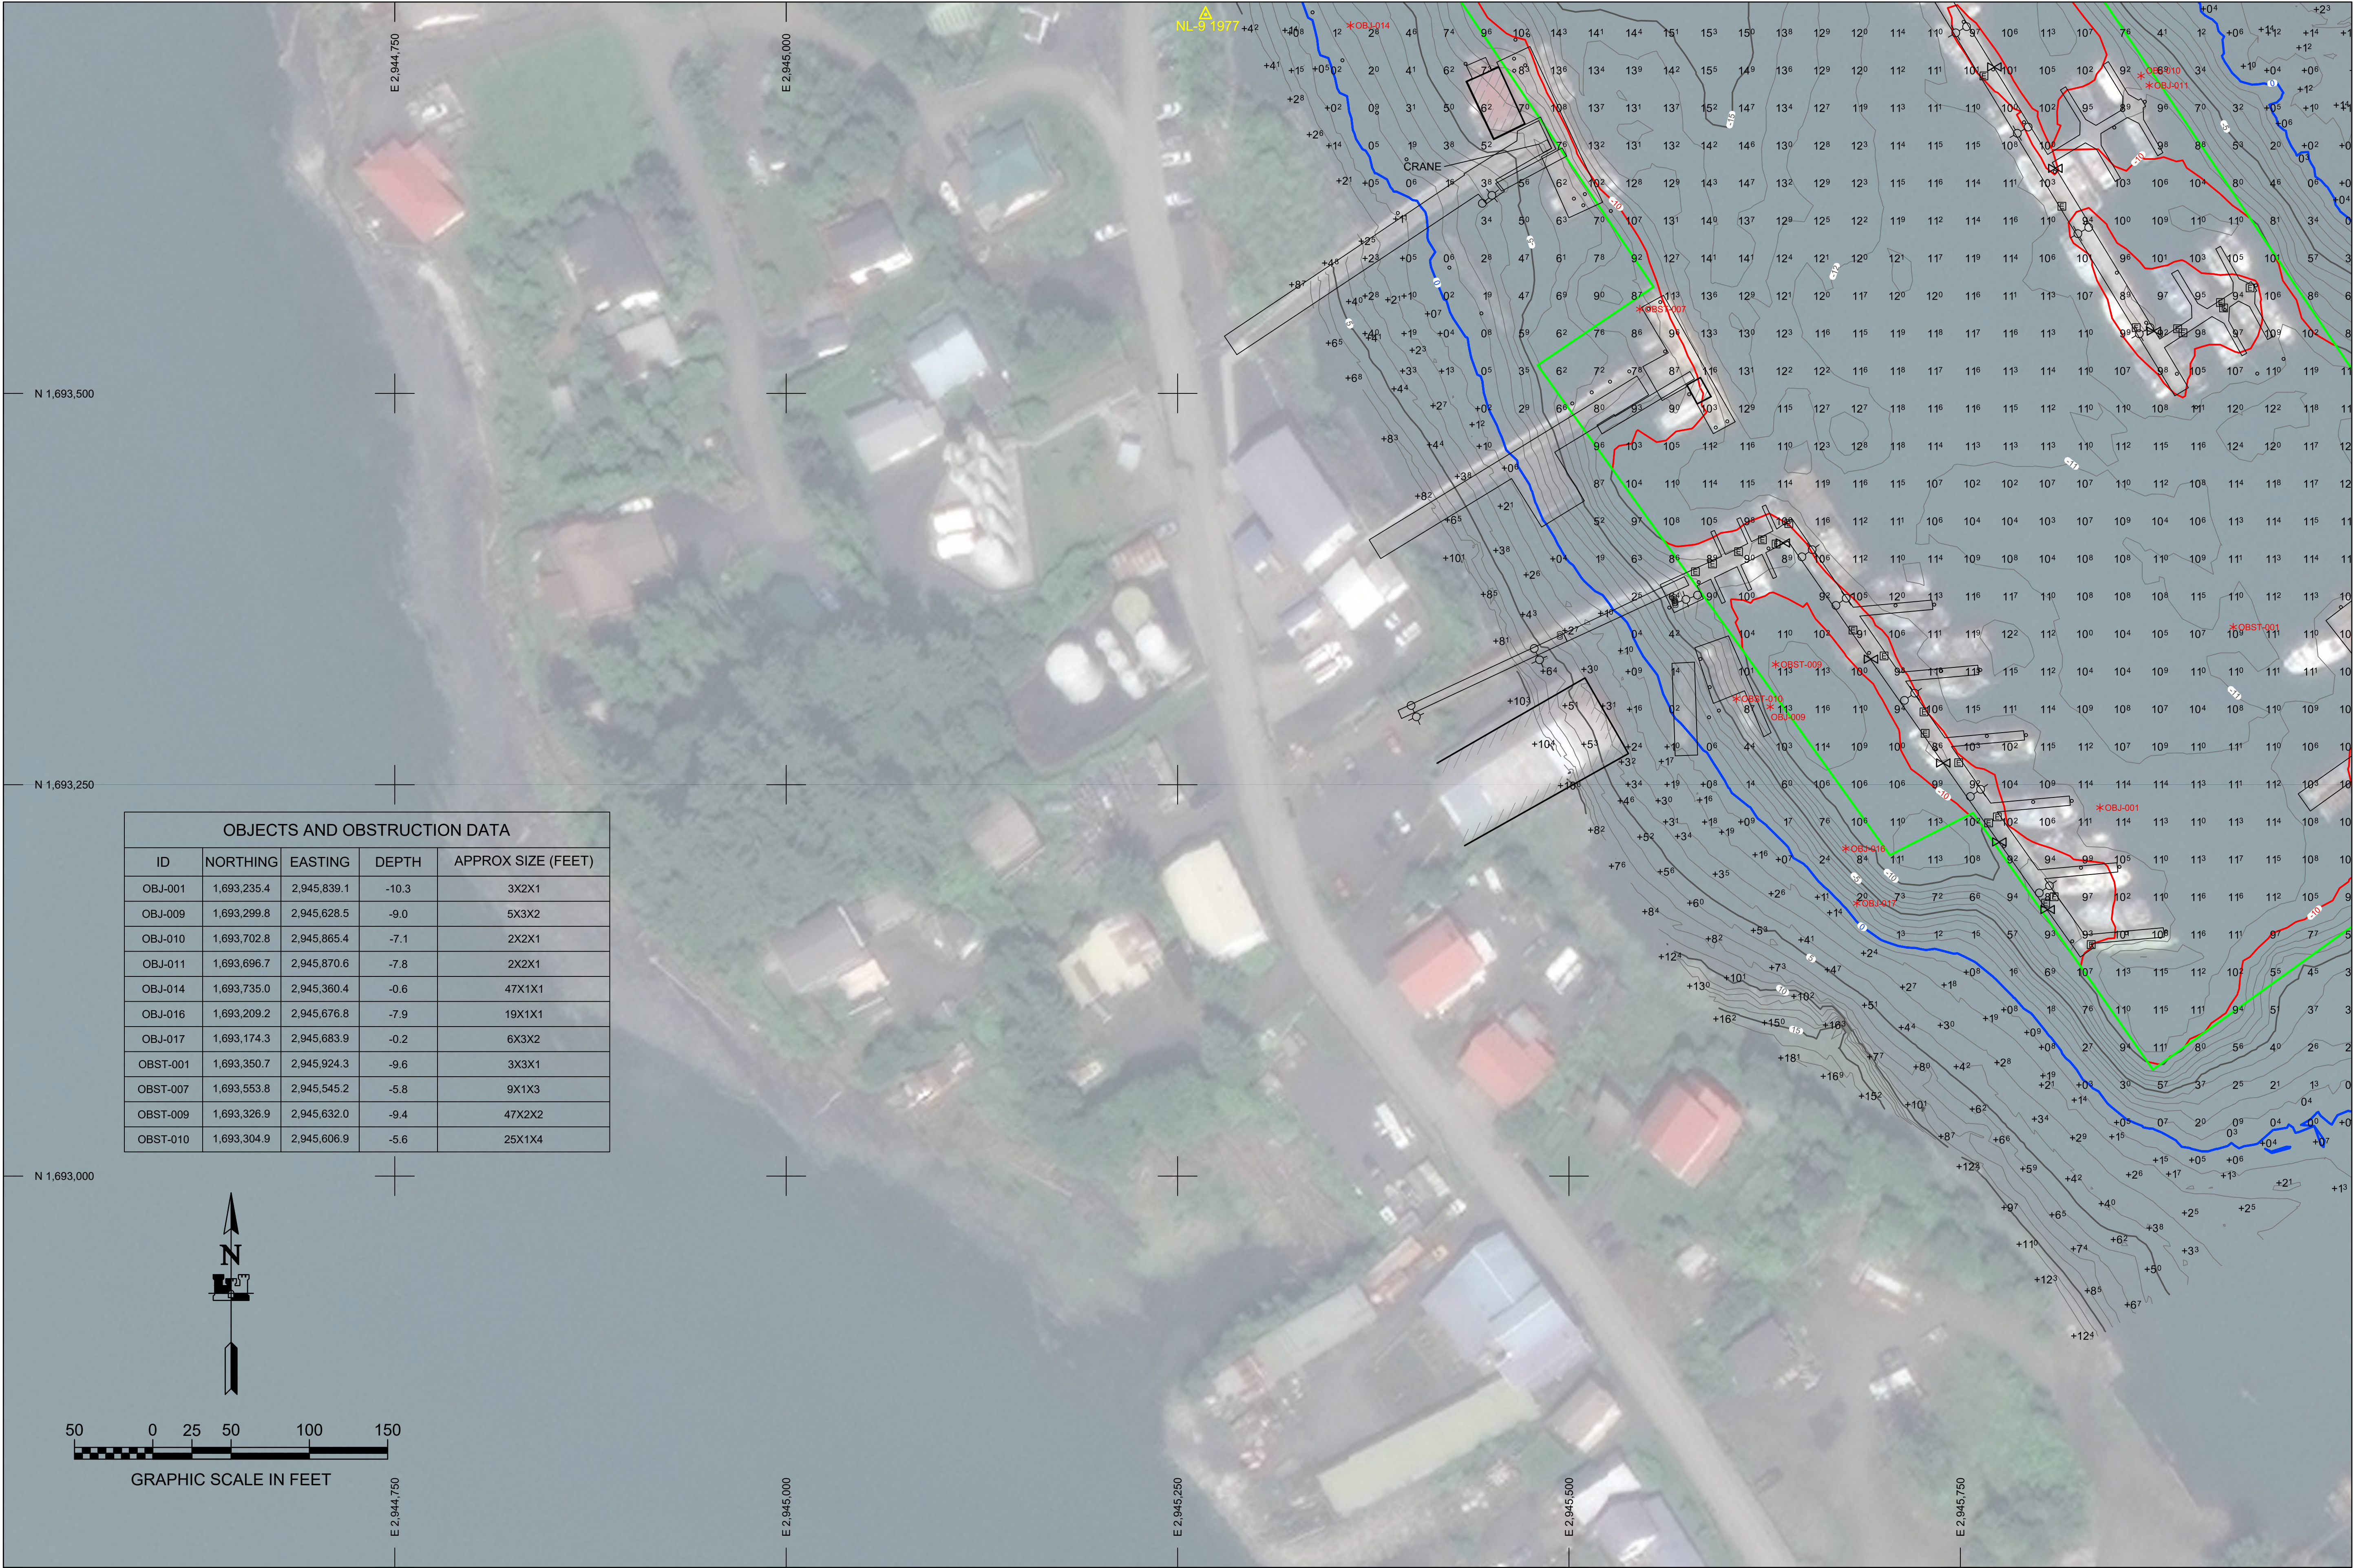

OBJECTS AND OBSTRUCTION DATA				
ID	NORTHING	EASTING	DEPTH	APPROX SIZE (FEET)
OBJ-001	1,693,235.4	2,945,839.1	-10.3	3X2X1
OBJ-009	1,693,299.8	2,945,628.5	-9.0	5X3X2
OBJ-010	1,693,702.8	2,945,865.4	-7.1	2X2X1
OBJ-011	1,693,696.7	2,945,870.6	-7.8	2X2X1
OBJ-014	1,693,735.0	2,945,360.4	-0.6	47X1X1
OBJ-016	1,693,209.2	2,945,676.8	-7.9	19X1X1
OBJ-017	1,693,174.3	2,945,683.9	-0.2	6X3X2
OBST-001	1,693,350.7	2,945,924.3	-9.6	3X3X1
OBST-007	1,693,553.8	2,945,545.2	-5.8	9X1X3
OBST-009	1,693,326.9	2,945,632.0	-9.4	47X2X2
OBST-010	1,693,304.9	2,945,606.9	-5.6	25X1X4

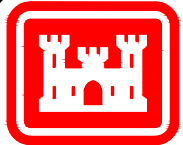



US ARMY CORPS
OF ENGINEERS®
ALASKA DISTRICT

REV.	DATE	BY	APPR.	DESCRIPTION

SURVEYED BY: GREGORY W. GIBSON DRAWN BY: ROBERT GOUGHNOUR CHECKED BY: TASJGGVWG APPROVED BY: THOMAS SLOAN, CHIEF GEOMATICS SECTION FILE: 021500_VH02.DWG	UPC: 021500	CONTRACT NO.: W811K16-16-D-0014
	PLOT DATE: 07 October 2019	TASK ORDER NO.: 19PD064
	SIZE: ANSI D	JOB NO.: 119
	SCALE: 1" = 50'	CONTRACTOR: ETEC INC. CITY: WASILLA STATE: ALASKA

WRANGELL, ALASKA
021500 - WRANGELL HARBOR
PROJECT CONDITION SURVEY
AUGUST 8 - AUGUST 14, 2019

REFERENCE
NUMBER:
1-WRA-92-07-56
SHEET 3 OF 6

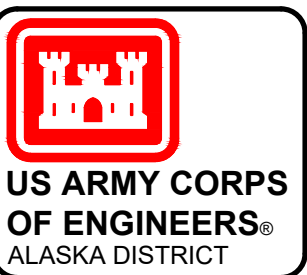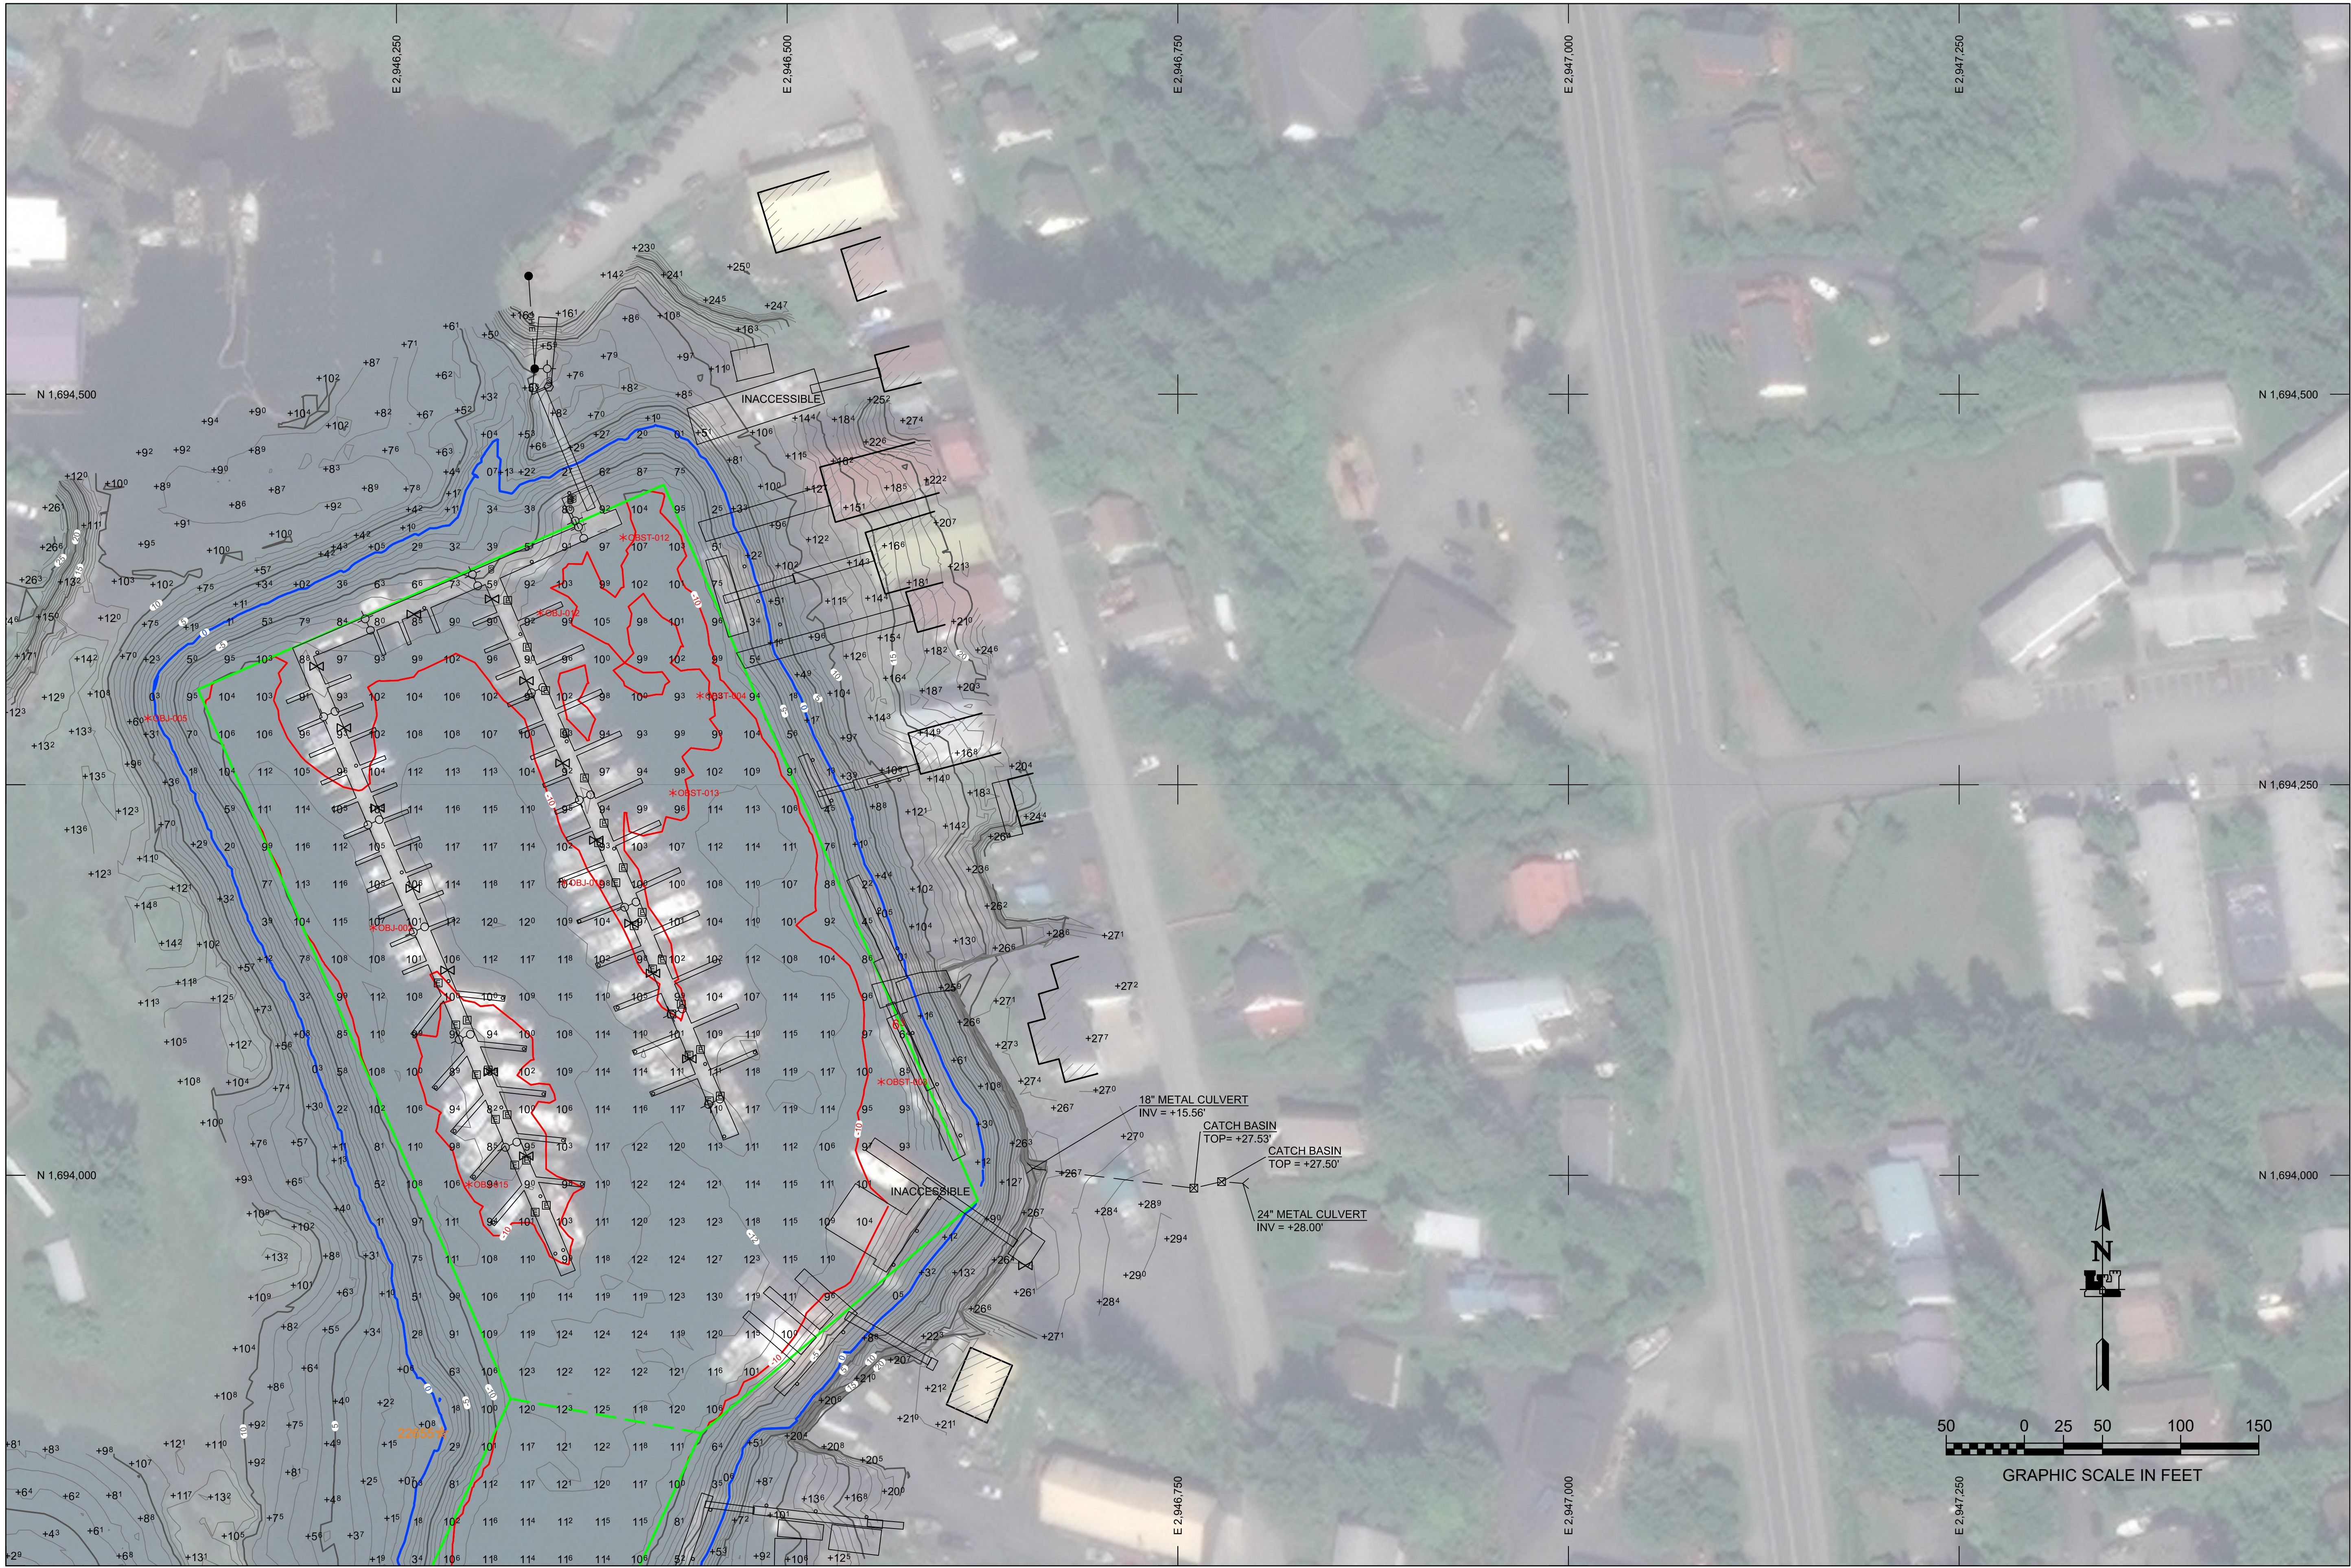


REV.	DATE	BY	APPR.	DESCRIPTION


	U.S. ARMY CORPS OF ENGINEERS ALASKA DISTRICT 2204 3RD STREET BER, ALASKA 99506-0988	SURVEYED BY: GREGORY W. GIBSON	UPC: 021500	CONTRACT NO.: W811KB-16-D-0014
		DRAWN BY: ROBERT GOUGHNOUR	PLOT DATE: 07 October 2019	TASK ORDER NO.: 19PD0064
		CHECKED BY: TASJBG/GVG	SIZE: ANSI D	JOB NO.: 1119
		APPROVED BY: THOMAS SLOAN, CHIEF GEOMATICS SECTION	SCALE: 1" = 50'	CONTRACTOR: ETEC INC.
		FILE: 021500_VH02.DWG	STATE: ALASKA	

WRANGELL, ALASKA
021500 - WRANGELL HARBOR
PROJECT CONDITION SURVEY
AUGUST 8 - AUGUST 14, 2019

REFERENCE
NUMBER:
1-WRA-92-07-56
SHEET 4 OF 6

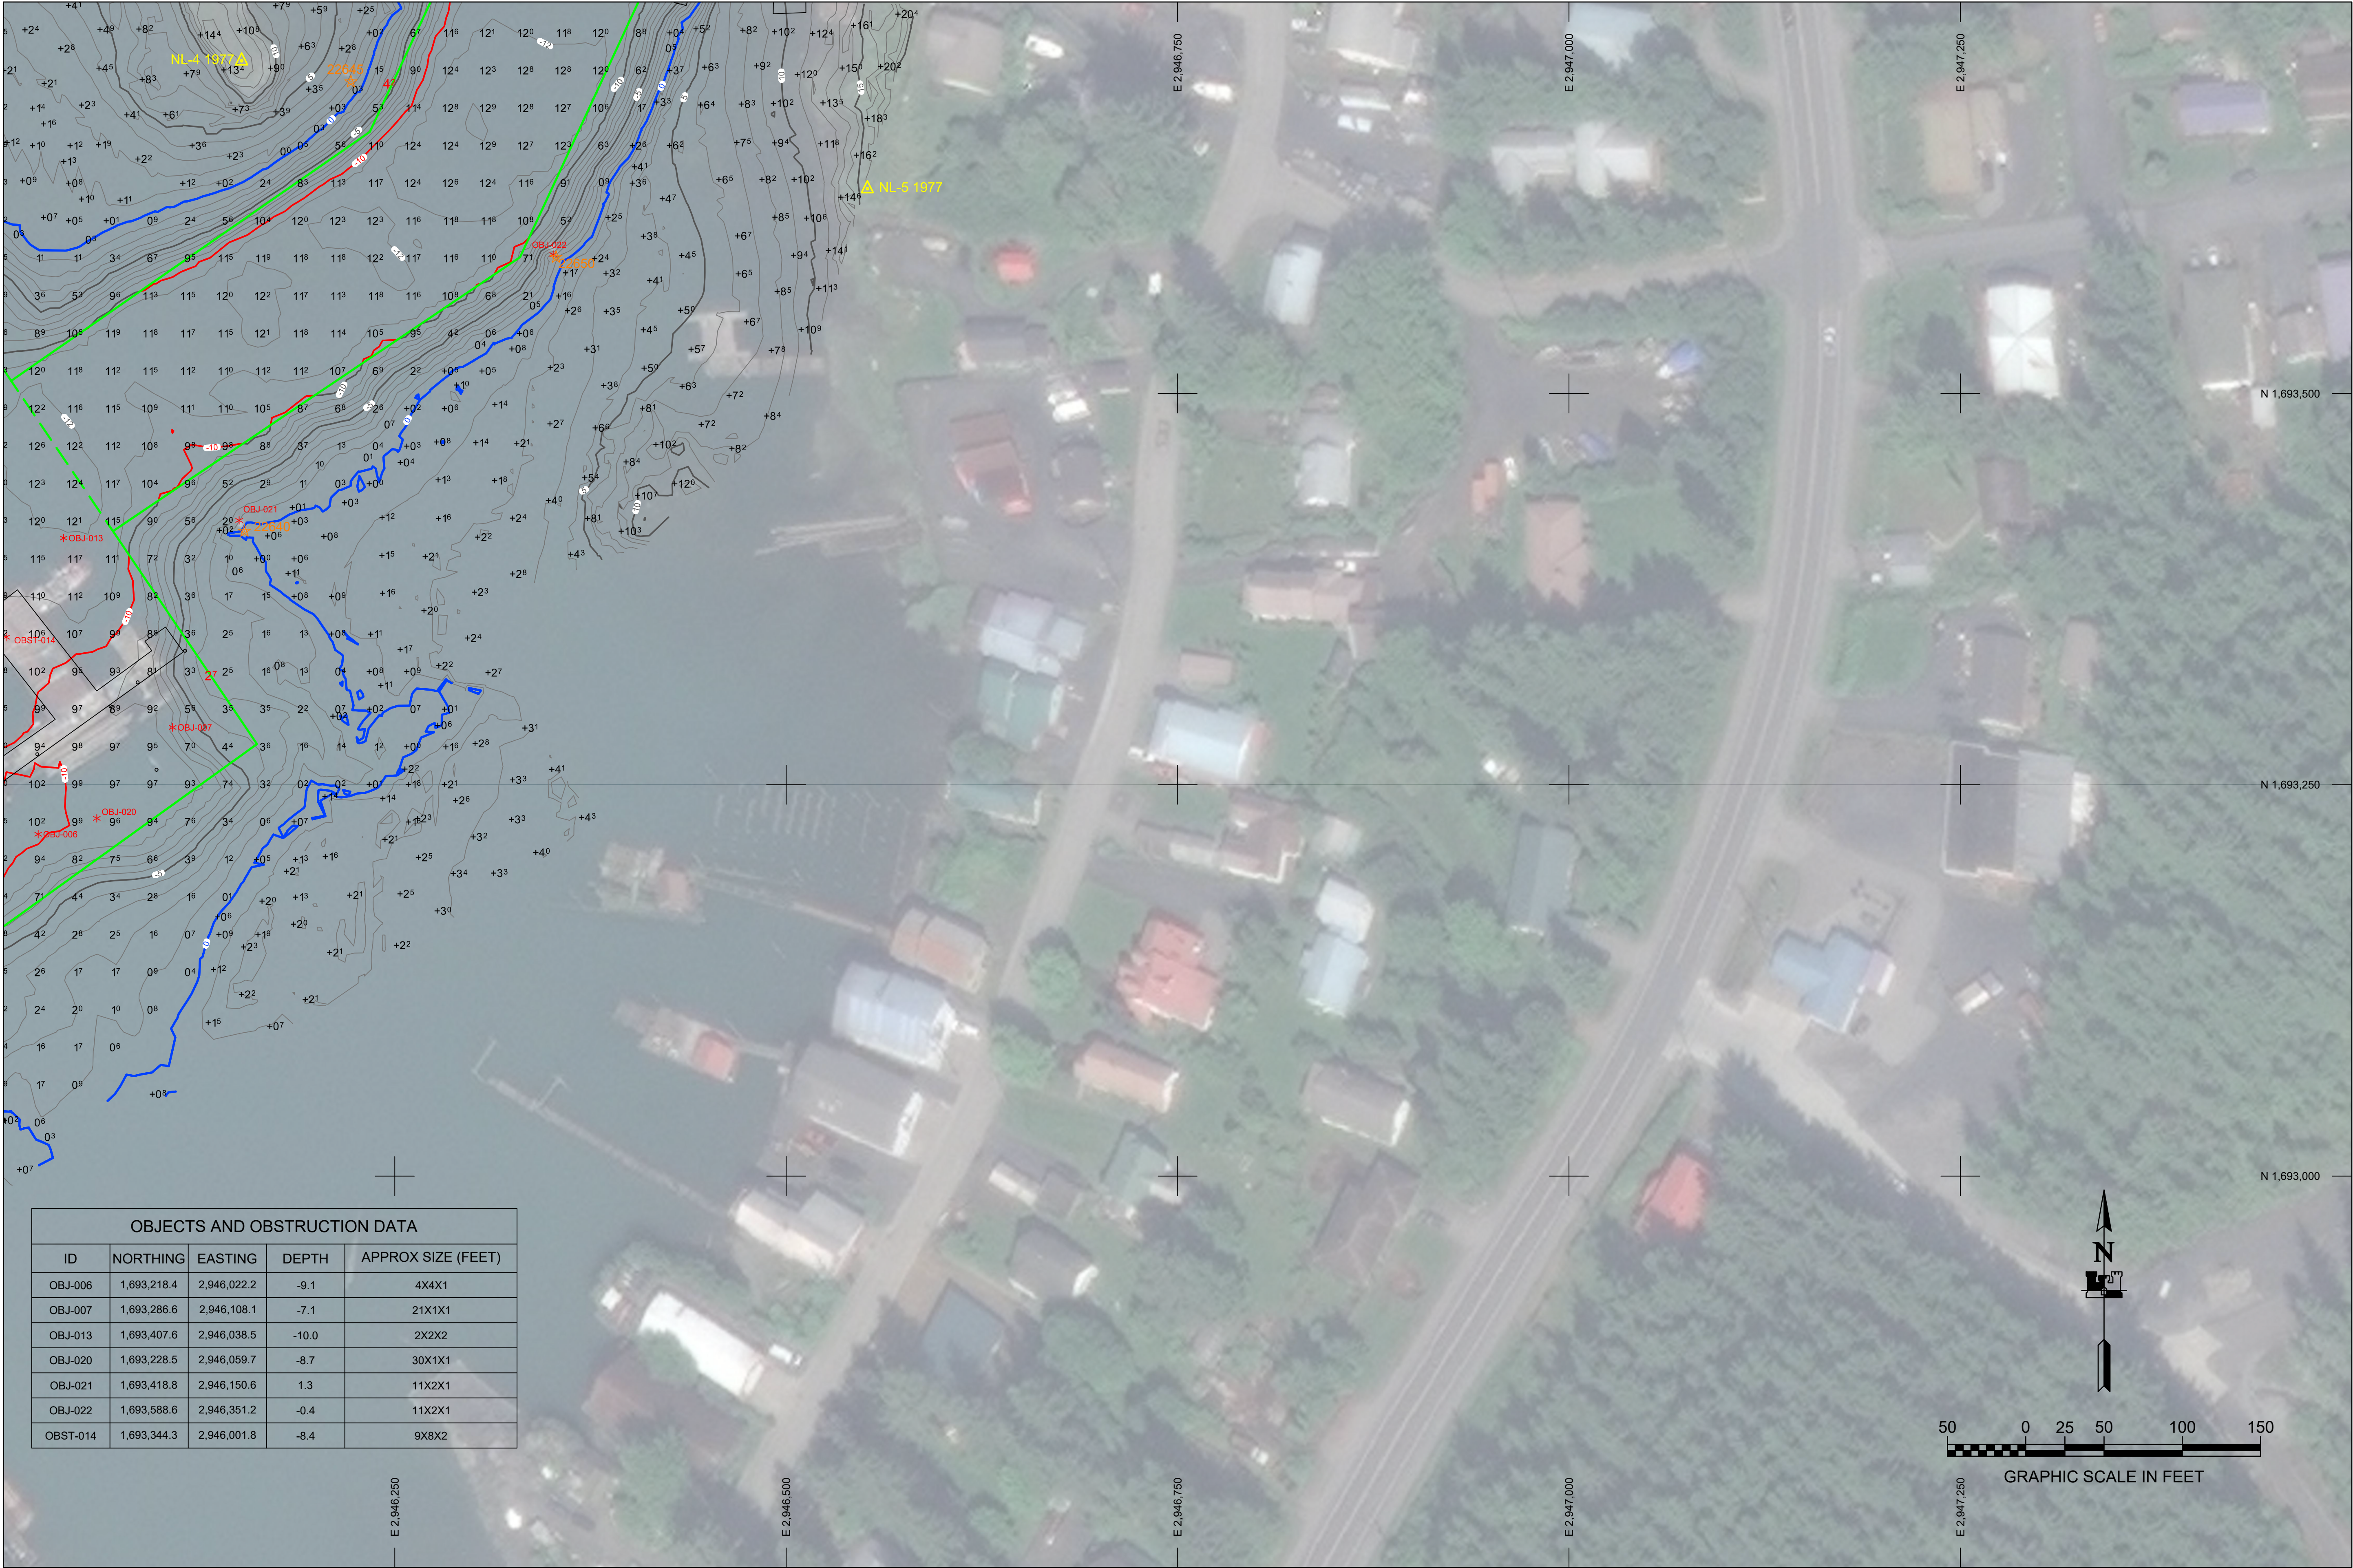

OBJECTS AND OBSTRUCTION DATA				
ID	NORTHING	EASTING	DEPTH	APPROX SIZE (FEET)
OBJ-006	1,693,218.4	2,946,022.2	-9.1	4X4X1
OBJ-007	1,693,286.6	2,946,108.1	-7.1	21X1X1
OBJ-013	1,693,407.6	2,946,038.5	-10.0	2X2X2
OBJ-020	1,693,228.5	2,946,059.7	-8.7	30X1X1
OBJ-021	1,693,418.8	2,946,150.6	1.3	11X2X1
OBJ-022	1,693,588.6	2,946,351.2	-0.4	11X2X1
OBST-014	1,693,344.3	2,946,001.8	-8.4	9X8X2

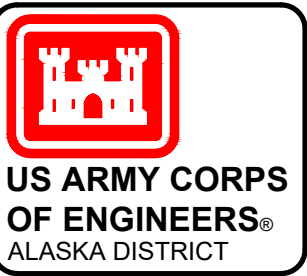

REV.	DATE	BY	APPR.	DESCRIPTION



	SURVEYED BY: GREGORY W. GIBSON		UPC: 021500	CONTRACT NO.: W911KG-16-D-0014	
	DRAWN BY: ROBERT GOUGHNOUR		PLOT DATE: 07 October 2019	TASK ORDER NO.: 19PD064	
	CHECKED BY: TASHIGGONG		SIZE: 11" x 17"	JOB NO.: 119	
	APPROVED BY: THOMAS SLOAN, CHIEF GEOMATICS SECTION		ANSI D 11:50	DRAWN BY: TASHIGGONG	
FILE: 021500_VH02.DWG			CITY: WASILLA	STATE: ALASKA	

WRANGELL, ALASKA

021500 - WRANGELL HARBOR

PROJECT CONDITION SURVEY

AUGUST 8 - AUGUST 14, 2019

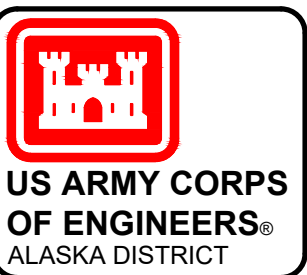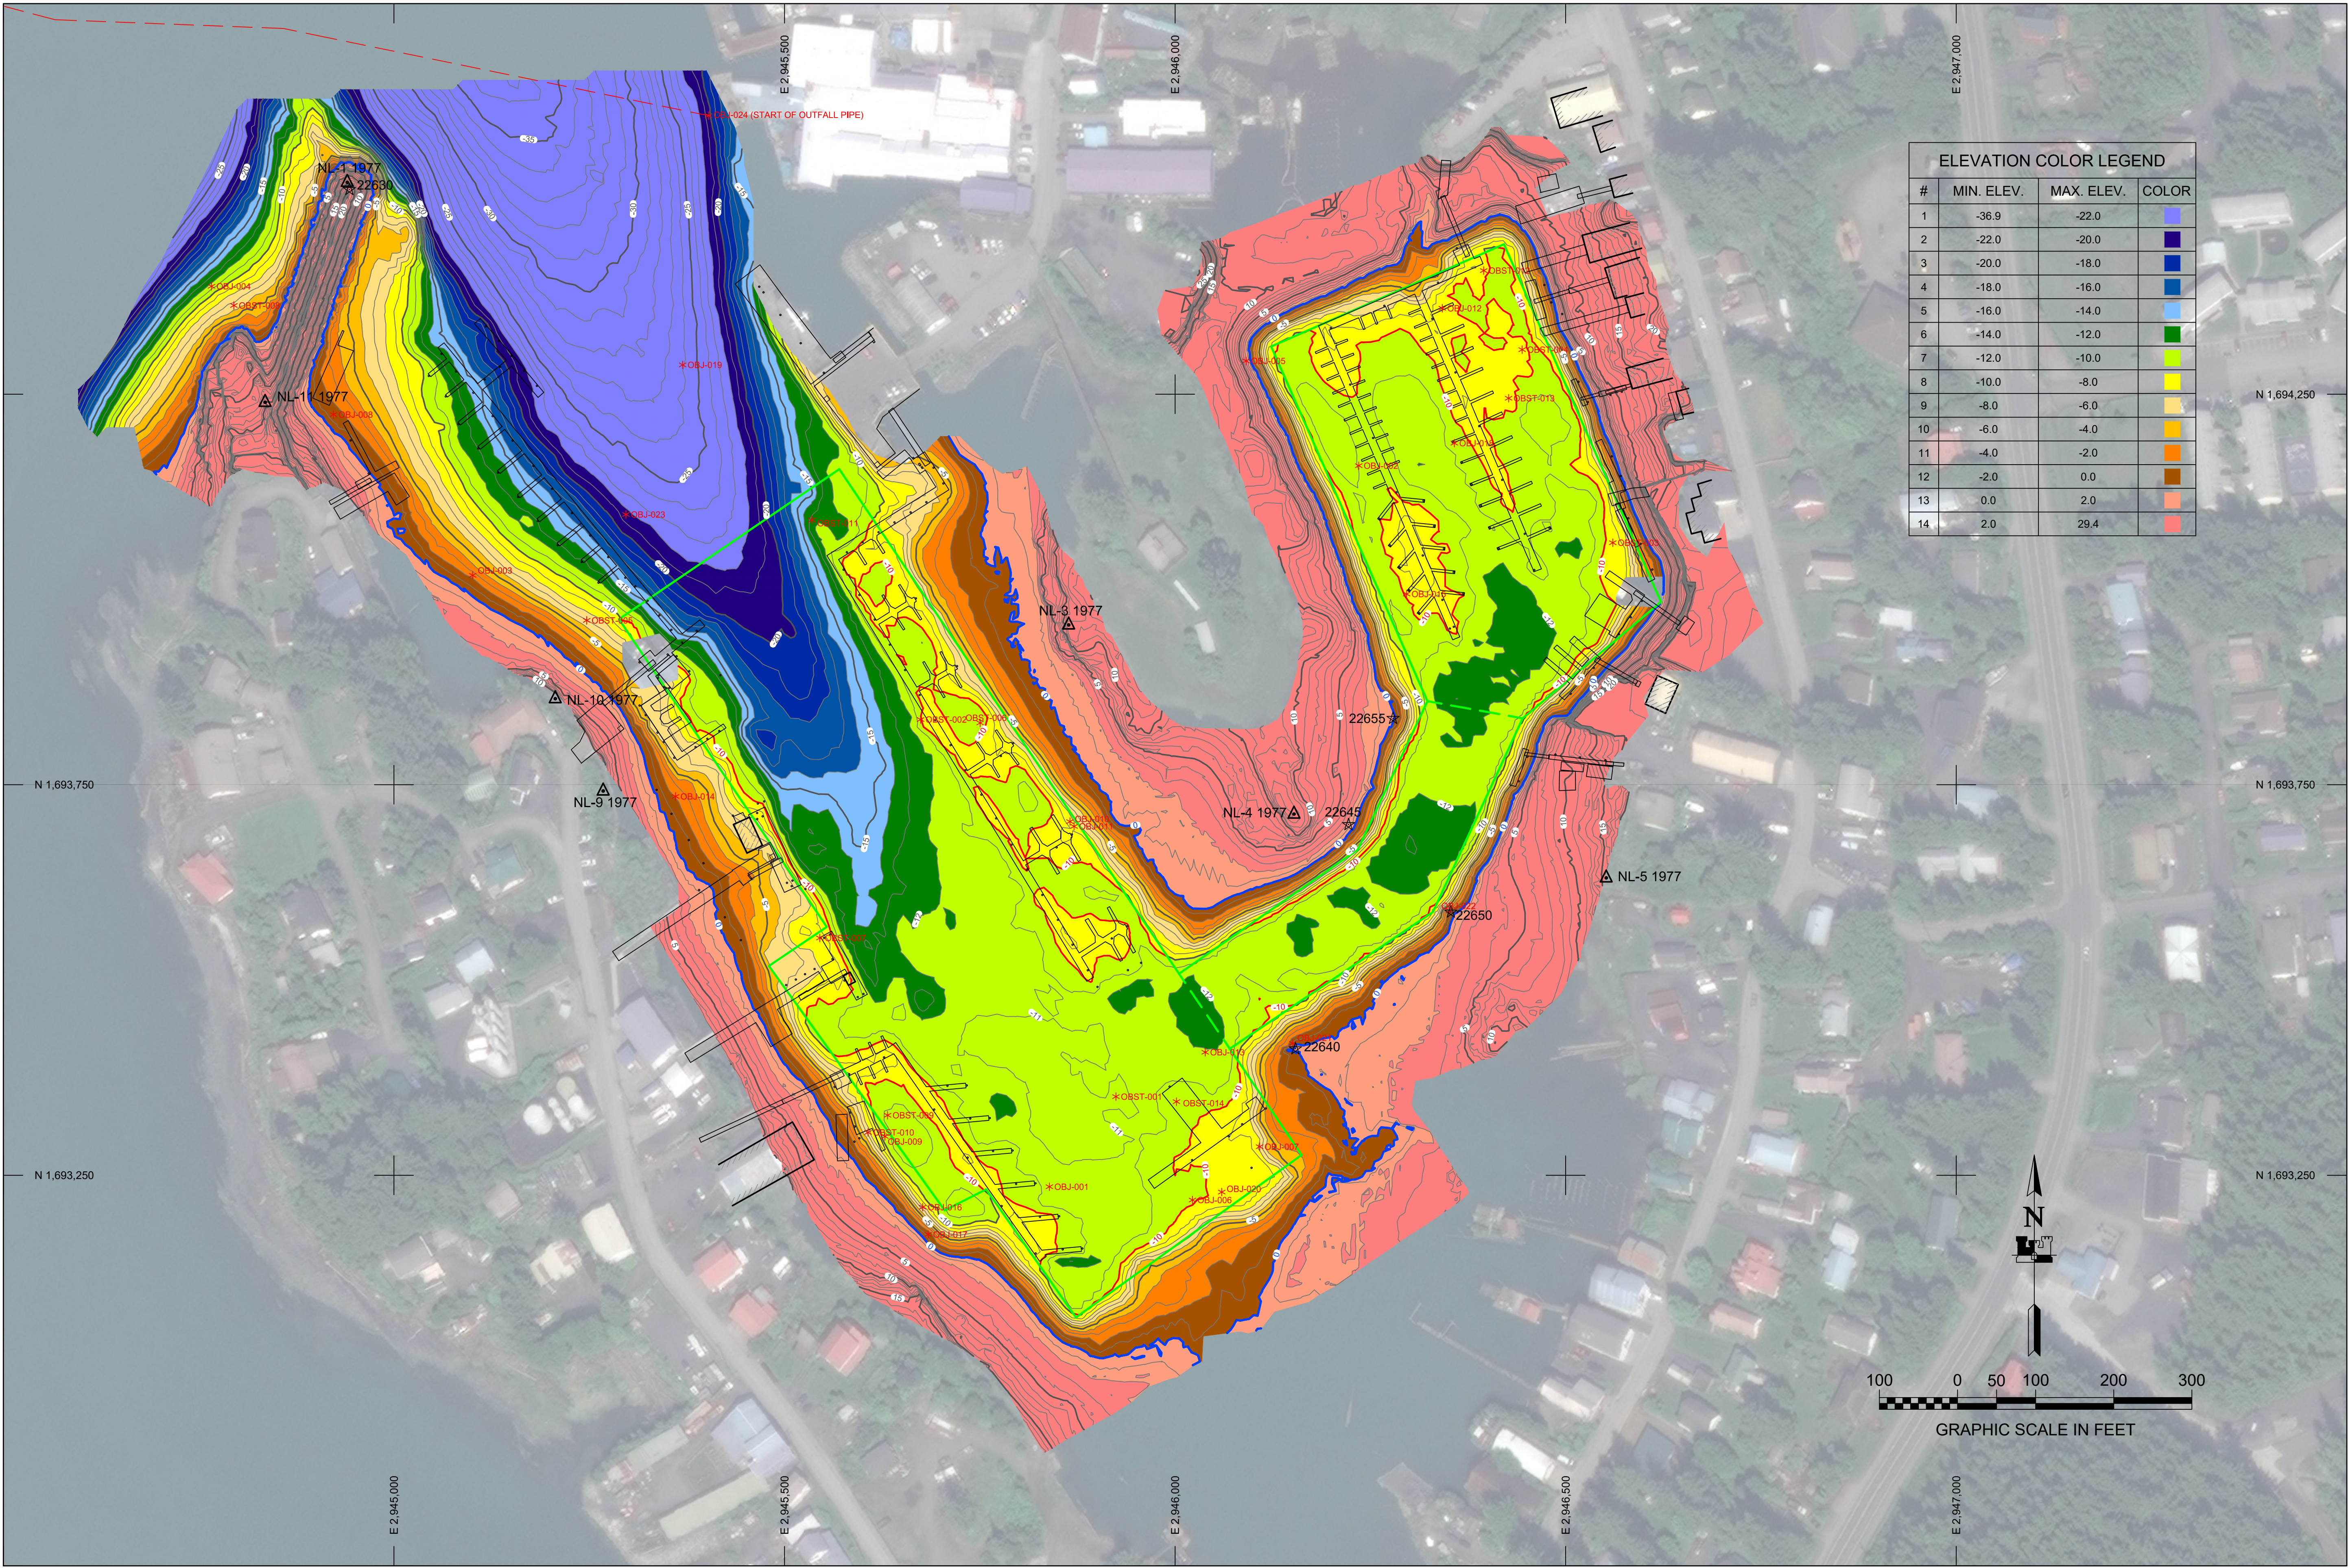

REV.		DATE	BY	APPR.	DESCRIPTION

	SURVEYED BY: GREGORY W. GIBSON		UPC: 021500	CONTRACT NO.: W911KG-16-D-0014	
	DRAWN BY: ROBERT GOUGHINOUR		PLOT DATE: 07 October 2019	TASK ORDER NO.: 19P0064	
	CHECKED BY: TASHIGGONG		SIZE: 11" x 17"	JOB NO.: 1119	
	APPROVED BY: THOMAS SLOAN, CHIEF GEOMATICS SECTION		ANSI D 11 = 100"	CONTRACTOR: ETRAC INC.	
FILE: 021500_VH02.DWG			CITY: WASILLA	STATE: ALASKA	

WRANGELL, ALASKA
021500 - WRANGELL HARBOR
PROJECT CONDITION SURVEY
AUGUST 8 - AUGUST 14, 2019

REFERENCE
NUMBER:
1-WRA-92-07-56
SHEET 6 OF 6